

MISSISSIPPI DEPARTMENT OF NATURAL RESOURCES

Bureau of Land and Water Resources

Southport Mall

P.O. Box 10631

Jackson, Mississippi 39209

WATER WELL DRILLERS LOG

CODED

E190
PIKE
5-16-84

5-16
date well completed

1984 *Fitzgerald Well Serv*
firm name

Pike
county well located

LANDOWNER:	description of formations encountered	from	to
<i>Billy Joe Deer</i>			
<i>Rd 1, McComb, Miss.</i> (mailing address)	<i>Red sand</i>	<i>20</i>	<i>60</i>
WELL LOCATION:	<i>White & blue clay</i>	<i>60</i>	<i>186</i>
sec. <i>3</i> T. <i>3</i> (N) R. <i>8</i> (E) W.	<i>Coarse sand & gravel</i>	<i>186</i>	<i>200</i>
<i>3</i> miles <i>E</i> of <i>McComb</i> (distance) (direction) (nearest town)			
WELL PURPOSE: <i>Home</i> (home, irrigation, municipal, industrial)			
WELL COMPLETION DATA:			
(1) diameter (inches) <i>4</i>			
(2) total depth (feet) <i>200</i>			
(3) static water level (feet) <i>70</i> below above top of ground.			
(4) casing <i>PVC</i> <i>192</i> (material) (depth)			
<i>4</i> (size) if telescope see back.			
(5) screen <i>8</i> <i>192</i> (length) (depth to top)			
<i>4</i> <i>PVC</i> (size) (material)			
(6) pump <i>1/2</i> <i>10</i> (HP) (yield gpm)			
<i>Electric</i> (type power)			
(7) electric log <i>No</i> (yes or no)			
<i>Land Shark</i> (organization running log)			
(8) how well bottom plugged <i>Land Shark</i>			
DRILLERS REMARKS:			


DEPT. OF NATURAL RESOURCES
BUREAU OF LAND & WATER RESOURCES

JUN 15 1984

RECEIVED

If well telescopes please sketch and show depths.

GROUND LEVEL

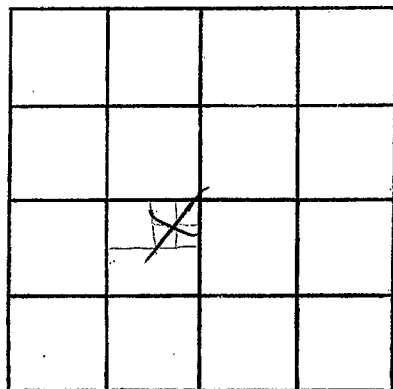

SECTION 3

Please indicate well location X.

ADDITIONAL INFORMATION

If more than one screen,
show locations of each on sketch.