

MISSISSIPPI DEPARTMENT OF NATURAL RESOURCES

Bureau of Land and Water Resources

Southport Mall

P.O. Box 10631

Jackson, Mississippi 39209

CODED

WATER WELL DRILLERS LOG

E 191
PIKE
5-29-84

5-29  
date well completed

1984

*Fitzgerald Well Sew*  
firm name

*Pike*  
county well located

LANDOWNER:	description of formations encountered	from	to
<i>Mike McKenzie</i>			
<i>R.B. McComb, Mrs.</i> (mailing address)	<i>Red sand</i>	<i>20</i>	<i>55</i>
	<i>Coarse sand &amp; gravel</i>	<i>55</i>	<i>70</i>
<b>WELL LOCATION:</b>			
sec. <i>28</i> T <i>3</i> (N) R <i>8</i> (E)			
<i>2</i> miles (distance) <i>E</i> (direction) of <i>Fernwood</i> (nearest town)			
<b>WELL PURPOSE:</b> <i>Home</i> (home, irrigation, municipal, industrial)			
<b>WELL COMPLETION DATA:</b>			
(1) diameter (inches) <i>4</i>			
(2) total depth (feet) <i>70</i>			
(3) static water level (feet) <i>25</i> below above top of ground.			
(4) casing (material) <i>PVC</i> , (depth) <i>62</i>			
<i>4</i> (size) if telescope see back.			
(5) screen (length) <i>8</i> , (depth to top) <i>62</i>			
<i>4</i> (size), <i>PVC</i> (material)			
(6) pump (HP) <i>1/2</i> , (yield gpm) <i>10</i>			
<i>elec</i> (type power)			
(7) electric log <i>No</i> (yes or no)			
(organization running log)			
(8) how well bottom plugged <i>Sand Shk</i>			

DEPT. OF NATURAL RESOURCES  
BUREAU OF LAND & WATER RESOURCES


JUN 15 1984

RECEIVED

DRILLERS REMARKS:

If well telescopes please  
sketch and show depths.

GROUND LEVEL

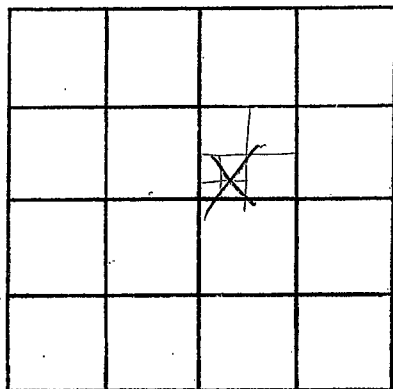

SECTION 28

Please indicate well location X.

ADDITIONAL INFORMATION

If more than one screen,  
show locations of each on sketch.