

MISSISSIPPI DEPARTMENT OF NATURAL RESOURCES
 Bureau of Land and Water Resources
 Southport Mall
 P.O. Box 10631
 Jackson, Mississippi 39209
 WATER WELL DRILLERS LOG

CODED

Pike
E 195

9/5/84 19 MOORHIS CO. CO. PIKE
 date well completed firm name county well located

LANDOWNER:	description of formations encountered	from	to
<u>JUSTISS DIE CO</u>	<u>SANDY CLAY</u>	<u>0</u>	<u>20'</u>
<u>DRAWEL AL</u>			
<u>JENA, LA 71342</u> (mailing address)	<u>SAND</u>	<u>20</u>	<u>120</u>
<u>WELL LOCATION:</u>	<u>SAND - GRAVEL</u>	<u>120</u>	<u>140</u>
sec. <u>12</u> T. <u>3</u> N R. <u>8</u> E	<u>BLUE CLAY</u>	<u>140</u>	<u>160</u>
<u>3/4</u> miles <u>E</u> of <u>McLoud</u>	<u>SANDY CLAY</u>	<u>160</u>	<u>370</u>
(distance) (direction) (nearest town)	<u>MEDIUM SAND</u>	<u>370</u>	<u>420</u>
<u>WELL PURPOSE: PIG SUMPY</u> (home, irrigation, municipal, industrial)			
<u>WELL COMPLETION DATA:</u>			
(1) diameter (inches) <u>4"</u>			
(2) total depth (feet) <u>420'</u>			
(3) static water level (feet) <u>30</u> ^{below} / _{above} top of ground.			
(4) casing <u>PVC</u> , <u>400'</u> (material) (depth)			
<u> </u> If telescope see back. (size)			
(5) screen <u>20'</u> , <u>400'</u> (length) (depth to top)			
<u>4"</u> , <u>PVC</u> (size) (material)			
(6) pump <u>1 1/2</u> , <u>75</u> (HP) (yield gpm)			
<u>ELECT</u> (type power)			
(7) electric log <u>No</u> (yes or no)			
<u> </u> (organization running log)			
(8) how well bottom plugged <u>BACK WASH</u> <u>VALVE</u>			

CODED

DEPT. OF NATURAL RESOURCES
 BUREAU OF LAND & WATER RESOURCES

SEP 17 1984

RECEIVED


DRILLERS REMARKS:

If well telescopes please sketch and show depths.

GROUND LEVEL

400'
PVC

20'
SCREEN

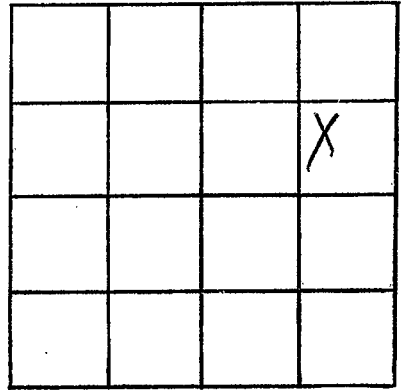

SECTION _____

Please indicate well location X.

ADDITIONAL INFORMATION

If more than one screen,
show locations of each on sketch.