

MISSISSIPPI DEPARTMENT OF NATURAL RESOURCES
 Bureau of Land and Water Resources
 Southport Mall
 P.O. Box 10631
 Jackson, Mississippi 39209
WATER WELL DRILLERS LOG

CODED

PIKE
 E196
 11-84

Nov. 19 84 GRIVER DRILLING SER PIKE
 date well completed firm name county well located

LANDOWNER:	description of formations encountered	from	to
<u>PEPSI COLA CO.</u>			
<u>McCOMB, Ms.</u> (mailing address)	<u>SAND & CLAY STRATIS</u>	<u>3</u>	<u>14</u>
	<u>SANDY CLAY</u>	<u>14</u>	<u>40</u>
	<u>SAND + gen GRAVEL</u>	<u>40</u>	<u>130</u>
	<u>CLAY</u>	<u>130</u>	<u>172</u>
	<u>SAND</u>	<u>172</u>	<u>293</u>
	<u>CLAY, Hard</u>	<u>293</u>	<u>594</u>
	<u>SAND</u>	<u>594</u>	<u>672</u>
	<u>CLAY</u>	<u>672</u>	<u>675</u>

WELL LOCATION: NW 1/4 SE 1/4 NE 1/4
 sec. 18 T. 3 N S R. 8 E W
 (distance) miles (direction) of (nearest town)

WELL PURPOSE:
 (home, irrigation, municipal, industrial)

- WELL COMPLETION DATA:
- (1) diameter (inches) 10 3/4
 - (2) total depth (feet) 652 Ft.
 - (3) static water level (feet) 204 ^{below}/_{above} top of ground.
 - (4) casing steel, 609,
 (material) (depth)
10 3/4 if telescope see back.
 (size)
 - (5) screen 40, 612
 (length) (depth to top)
6" (.016) 304 S.S.
 (size) (material)
 - (6) pump 40 250
 (HP) (yield gpm)
Elect.
 (type power)
 - (7) electric log Yes
 (yes or no)
MGS
 (organization running log)
 - (8) how well bottom plugged Back
WASH VALVE 2 1/2" size

DRILLERS REMARKS:


RECEIVED
 FEB 8 1985

Department of Natural Resources
 Bureau of Land & Water Resources

7

If well telescopes please
sketch and show depths.

GROUND LEVEL

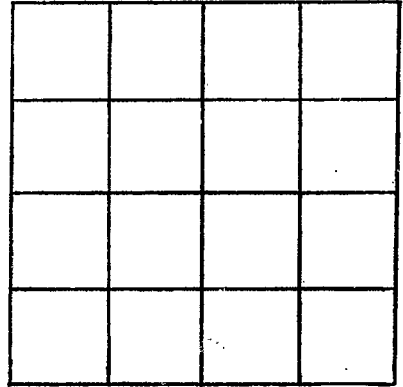

SECTION _____

Please indicate well location X.

ADDITIONAL INFORMATION

If more than one screen,
show locations of each on sketch.