

MISSISSIPPI DEPARTMENT OF NATURAL RESOURCES

Bureau of Land and Water Resources

Southport Mall

P.O. Box 10631

Jackson, Mississippi 39209

CODED

WATER WELL DRILLERS LOG
TOM GRIFFITH

PLUMBING & WELL SERVICE, INC. PIKE

E197
PIKE
4-26-84

4-26 1984
date well completed

320 MAXSON AVE.
COLUMBIA, MS 39429

county well located

LANDOWNER: ANR Production Co

description of formations encountered

from

to

111 Building

Jackson, Ms.
(mailing address)

Clay - Gravel	0	30
Chalk	30	55
Pea Gravel and sand	55	90
Chalk	90	120
Pea Gravel	120	160
Rock	160	162
Pea Gravel	162	250

WELL LOCATION:

sec. 12 T-3^N R-8^E
5 miles NE of McComb
(distance) (direction) (nearest town)

WELL PURPOSE: oil huc
(home, irrigation, municipal, industrial)

WELL COMPLETION DATA:

- (1) diameter (inches) 4"
- (2) total depth (feet) 250
- (3) static water level (feet) 70' below top of ground.
- (4) casing 74C 210'
(material) (depth)
4" (size) if telescope see back.
- (5) screen 40' 210'
(length) (depth to top)
4" (size) slot (material)
- (6) pump Air Lift
(HP) (yield gpm)
Diesel (type power)
- (7) electric log no
(yes or no)
n/a (organization running log)
- (8) how well bottom plugged welded

#1 L.R. Hamilton

400' S + 2000' W

of NE 1/4 of sec.

DEPT. OF NATURAL RESOURCES
BUREAU OF LAND & WATER RESOURCES


DEC 10 1984

RECEIVED

DRILLERS REMARKS:

If well telescopes please sketch and show depths.

GROUND LEVEL

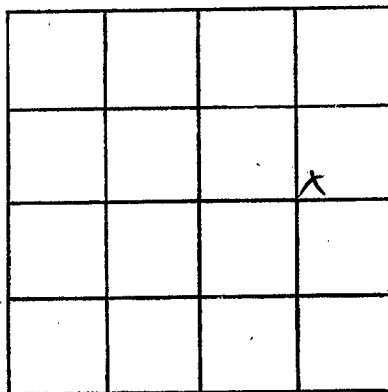

SECTION 12

Please indicate well location X.

ADDITIONAL INFORMATION

If more than one screen,
show locations of each on sketch.