

MISSISSIPPI DEPARTMENT OF NATURAL RESOURCES

Bureau of Land and Water Resources

Southport Mall

P.O. Box 10631

Jackson, Mississippi 39209

WATER WELL DRILLERS LOG

CODED

E 198
PIKE
11-27-84

Griner Drilling Service, Inc.

Pike

11-27-84
date well completed

Griner Drilling Service, Inc.
firm name

Pike
county well located

LANDOWNER:
R. E. Williams
P.O. Box 698
Natchez, Ms. 39120
(mailing address)

description of formations encountered

from to

sand, gravel

0 210

clay

210 430

WELL LOCATION: 366' N 45 56 1/2' E
sec. 2 T. 30 N. R. 8 E 1/4 of
No. 1 Friendship NE
Baldwin (distance) (direction) (nearest town)

sand, gravel

430 504

WELL PURPOSE: oil field supply
(home, irrigation, municipal, industrial)

CODED

WELL COMPLETION DATA:

- (1) diameter (inches) 3"
- (2) total depth (feet) 504'
- (3) static water level (feet) 130' ^{below} _{above} top of ground.
- (4) casing steel 504'
(material) (depth)
3" if telescope see back.
(size)
- (5) screen 42' 462'
(length) (depth to top)
3" perforated
(size) (material)
- (6) pump - 65-70
(HP) (yield gpm)
AC
(type power)
- (7) electric log (yes or no)
(organization running log)
- (8) how well bottom plugged orange peel

DEPT. OF NATURAL RESOURCES
BUREAU OF LAND & WATER RESOURCES


DEC 19 1984

RECEIVED

DRILLERS REMARKS:

If well telescopes please
sketch and show depths.

GROUND LEVEL

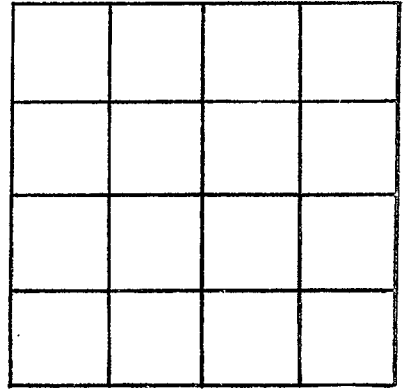

SECTION _____

Please indicate well location X.

ADDITIONAL INFORMATION

If more than one screen,
show locations of each on sketch.