

MISSISSIPPI DEPARTMENT OF NATURAL RESOURCES
 Bureau of Land and Water Resources
 Southport Mall
 P.O. Box 10631
 Jackson, Mississippi 39209
WATER WELL DRILLERS LOG

PIKE
E 199
5-14-85

5-14 1985 Heulavel Ser Pike
 date well completed firm name county well located


LANDOWNER:	description of formations encountered	from	to
<u>Albert Fann</u>			
<u>RR. 1 McComb, ms.</u> (mailing address)	<u>Red Clay</u> <u>Red Sand</u> <u>Coarse Sandstone</u>	<u>0</u> <u>20</u> <u>105</u>	<u>20</u> <u>105</u> <u>120</u>
WELL LOCATION:			
sec. <u>6</u> T. <u>3</u> N. R. <u>8</u> E S W <u>1/4</u> miles <u>E</u> of <u>McComb</u> (distance) (direction) (nearest town)			
WELL PURPOSE: <u>Home</u> (home, irrigation, municipal, industrial)			
WELL COMPLETION DATA:			
(1) diameter (inches) <u>4</u>			
(2) total depth (feet) <u>120</u>			
(3) static water level (feet) <u>80</u> below above top of ground.			
(4) casing <u>PVC</u> , <u>110</u> , (material) (depth) <u>4</u> if telescope see back. (size)			
(5) screen <u>10</u> , <u>110</u> (length) (depth to top) <u>4</u> , <u>PVC</u> (size) (material)			
(6) pump <u>1/2</u> , <u>10</u> (HP) (yield gpm) <u>Elm</u> (type power)			
(7) electric log <u>no</u> (yes or no) <u>Elm</u> (organization running log)			
(8) how well bottom plugged <u>Sand blk</u>			
DRILLERS REMARKS:			

RECEIVED
 MAY 17 1985

Department of Natural Resources
 Bureau of Land & Water Resources

If well telescopes please sketch and show depths.

GROUND LEVEL

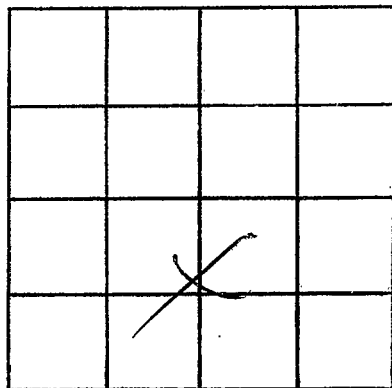

SECTION 6

Please indicate well location X.

ADDITIONAL INFORMATION

If more than one screen,
show locations of each on sketch.