
	· 11 D	• ·	
	ell Report	For Office Use Only:	
Mississippi Departmen	t of Environmental Quality	Aquifer:	
	Office of Land and Water Resources		
P.U.I	lox 10631 IS 39289-0631	L. S. Elevation:	
	961-5210		
(601)35	4-6938 (fax)	B-log #:	
State Law requires that this report be prepared by the driller in detail and filed with the Department within 30 days of completion of drilling of the well.			
Well Owner Information	Well	Location	
Owner Name Bobby Yawn	Latitude: 3/ • 13: 34	BLongitude: <u>90° 20/697</u> " 92	
Mailing Address: 1135 Heights Rd	Method of Lat/Long (circle or		
	USGS quad, Hand-held	DPS? Survey-grade OPS	
MCComb M5 39648 City State Zip Code	15 39648 SE 4 NE 4 Sec 1		
•	Distance Direction	Nearest Town of Holmes Ville	
Telephone No. (601) 250 - 5318		of HOIMES VILLE	
Well Data			
Purpose of Well (circle one) Home Industrial Public Supply Irrigation Fish Culture Other:			
Date well drilling started: 10/15/04 Date well drilling completed: 10/15/04			
If flowing, method of flow regulation: Valve Other (describe)			
Static Water Level:			
Method of Measurement (circle one) steel tape clectric tape) air line other:			
Hole depth: Well depth: Well grouted to a depth of feet			
Type of grout (circle one): Cement Hentonite Mix			
Casing length: <u>158</u> feet Casing diameter: <u>4</u> inches Type of casing: <u>PUC</u>			
Screen length:			
Screen slot size:inches Setting depth: Fromfeet tofeet to			
Type of completion (circle all applicable): Gravel packed Underreamed Telescoped Open hole Natural Development			
Other (describe):			
Top of lap pipe or reduction in casing:fect. If telescoped or more than one screen, describe on back of page			
Logs run (circle all applicable): No log run Electric Gamma Ray Density Sonic Neutron Other:			
Name of organization running log(s):			
I certify that the well was drilled, constructed, and completed in accordance with all applicable requirements of the Mississippi			
Department of Environmental Quality and/or the Mississippi I	epartment of Health regulation		
GRENN WATER WELL & SUPPLY, INC.	$R_{-} \cdot \gamma$	MS Junion	
Brian McClendon, lic. no. 0-664	Pruan /	<u>r winner</u>	
Print Name of Water Well Contractor and License No.	Signature	of Water Well Contractor	
· ·		. FECEIVE	


MAY G C. 2005 BY: OLWP If well telescopes please sketch below and show depths.

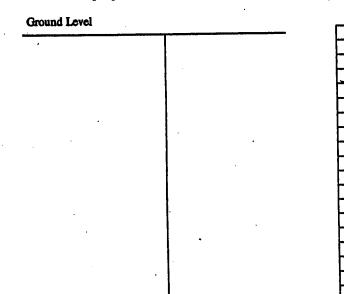

Description of Formations Encountered	From To
red clar	030
Sand	30 56
SUNO	56 135
STIERKY	
Sand	135 165
streaky sand white clay	168 177
and the second	
	━━┼━━━┤
	╺╾┼╌┈┥
•	
<u> </u>	
	╺╼╼┼╾╼╾┥╼╍╼┥
·	╍╍┥───┤

2-231

If more than one screen, show location of each on sketch

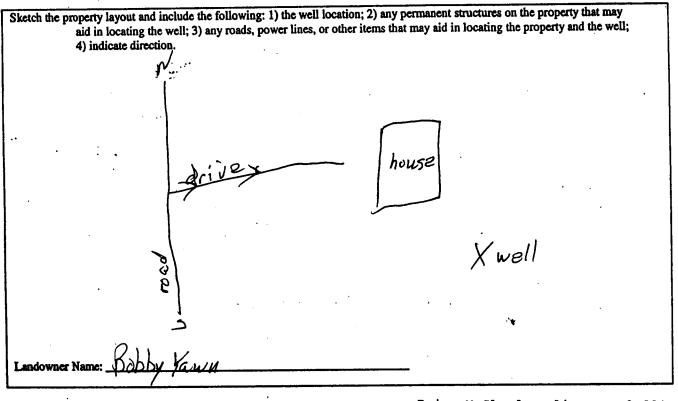

Signature of Water Well Contractor

Brian McClendon, lic. no. 0-664 GRENN WATER WELL & SUPPLY, INC.

STATE W	ELL REPORT	
County: Price Pump Installer Permit #: Mississippi Departme Driller: GRENN WATER WELL & P.O. SUPPLY, INC, Jackson, I Date completed: 5/1/05 (601	Part 2 's Completion Report int of Environmental Quality and Water Resources Box 10631 MS 39289-0631 961-5210 54-6938 (fax) il and filed with the Department within 30 days of the	
installation of pump. Well Owner Information		
Owner Name: <u>Babby Yawn</u> Mailing Address: <u>113 5 Heights Rd</u>	Well Location Latitude: $\underline{B1}^{0} \underline{13}^{'} \underline{343}^{''}$ Longitude: $\underline{90}^{\circ} \underline{20}^{'} \underline{697}^{''}$ Method of Lat/Long (circle one): Conventional Survey,	
<u>Mc(omb M6 39648</u> <u>City State Zip Code</u> <u>Telephone No. (601) 250 - 5318</u>	USGS quad, (Hand-held GPS) Survey-grade GPS $\underline{SE}_{4} \underline{NE}_{4}$ Sec 1 $\underline{3}$ Twn $\underline{3N}$ Rng $\underline{8E}$ Distance Direction Nearest Town $\underline{2}$ Miles \underline{NW} of $\underline{11e}$ mes v; $11e$	
Ритр Туре	Power Type	
Circle one	Circle one	
Air Lift Jet Submersible	Diesel Engine Gasoline Engine Natural Gas	
Bucket Piston Turbine	Electric Motor Hand Tractor PTO	
Centrifugal Rotary Flowing Well	Windmill Other (specify):	
Other (specify):	Horse Power Rating of Motor:	
Date Pump Installed: 511/05	Setting Depth: 125 feet	
Rated Pump Capacity: I D Gallons Per Minute	Number of Stages: 12	
Pump Test Data	Method of Measuring Water Level	
Date Well Tested: 5/1/05	Circle one	
Static Water Level (A): <u>95</u> Feet Below Land Surface	Air Line Electric Measuring Line Steel Tape Other (specify):	
Pumping Water Level (B): //OFeet Below Land Surface		
Drawdown [(B) - (A)]: Feet Below Land Surface	For flowing well, measured shut in head:feet	
Test Pumping Rate: 12. Gallons Per Minute		
Duration of Pump Test (minimum 4 hours): hours	15feet afterhours of pumping	
I HEREBY CERTIFY that the above statements are true to the best of GRENN WATER WELL & SUPPLY, INC. William Hardin, lic. no. 0-717P Print Name of Pump Installer and License No. (if applicable)	Signature of Pump Installer RECEIVED	
	MAY 0 6 2005	

.

BY: OLWR