

State Well Report

Part 1 - Driller's Log

Mississippi Department of Environmental Quality
Office of Land and Water Resources
P.O. Box 10631
Jackson, MS 39289-0631
(601)961-5210
(601)354-6938 (fax)

County: Pike
Permit #: _____
Driller: Fitzgerald Well Service
Date drilling completed: 4/12/06

For Office Use Only:
Aquifer: _____
Well #: E-242
L. S. Elevation: _____
E-log #: _____

State Law requires that this report be prepared by the license holder responsible for the work and filed with the Department at the above address within 30 days of completion of drilling of the well or borehole.

| Information on Well Owner (Landowner if borehole is not for a water well) | Well or Borehole Location |
|--|---|
| Owner Name: <u>Gerald Matthews</u> | Latitude: _____ Longitude: _____ |
| Mailing Address: <u>Summit-Holmesville Rd.</u> | Method of Lat/Long (circle one): <u>Conventional Survey</u> |
| <u>McComb, MS 39648</u> | USGS quad, Hand-held GPS, Survey-grade GPS |
| City State Zip Code | <u>1/4 1/4 Sec 12 Twn 3N Rng 8E</u> |
| Telephone No. () _____ | Distance Direction Nearest Town |
| | <u>5 Miles EAST of McComb</u> |

Well / Borehole Data

Date drilling started: 4/12/06 Date drilling completed: 4/12/06 Hole depth: 120' Hole diameter: 8"

Location of the source of any surface water used for drilling: _____
Method of dosing and volume of Chlorine used in drilling and development: _____

Logs run (circle all applicable): No log run Electric Gamma Ray Density Sonic Neutron Other: _____
Name of organization running log(s): _____

Purpose of borehole (check one): Water Well Geotechnical/Geological Investigation _____ Ground Source Heat Pump _____
Seismic Survey _____ Other (describe) _____

If drilling is not related to water well construction, skip the remainder of this block

Purpose of Well (check one): Home Industrial _____ Public Supply _____ Irrigation _____ Fish Culture _____ Other: _____

If a flowing well, method of flow regulation: Valve _____ Other (describe) _____

Static Water Level: 63 feet above or below (circle one) land surface Date measured: _____

Method of Measurement (circle one) steel tape electric tape air line other: _____

Well depth: 120' Well grouted to a depth of 10 feet Type of grout (circle one): Neat Cement Bentonite Mix

Casing length: 110 feet Casing diameter: 4" inches Type of casing: PVC

Screen length: 10 feet Screen diameter: 4" inches Type of screen: PVC

Screen slot size: .012 inches Setting depth: From 110 feet to 120 feet

Type of completion (circle all applicable): Gravel packed Underreamed Telescoped Open hole Natural Development
Other (describe): _____

Top of lap pipe or reduction in casing: _____ feet. *If telescoped or more than one screen, describe on next page*

Form: OLWR-SWR-1A


RECEIVED
APR 26 2006
BY: OLWR

E-242

The sketch below only required for water wells

If well telescopes, show depths on sketch.


Ground Level →

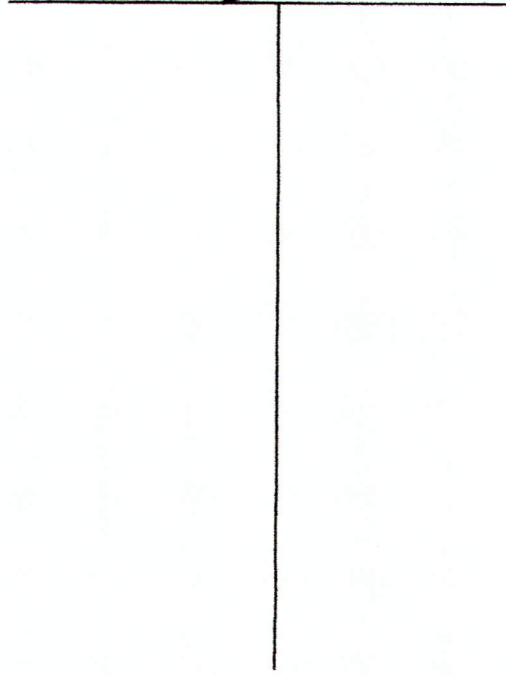

Description of formations encountered must be provided for all wells and boreholes, unless specifically exempted by regulations

| Description of Formations Encountered | From (depth) | To (depth) |
|---------------------------------------|--------------|------------|
| | Ground Level | |
| Clay | 0 | 30 |
| Sand & gravel | 30 | 70 |
| Clay | 70 | 90 |
| Sand | 90 | 110 |
| Coarse Sand & gravel | 110 | 120 |
| | | |
| | | |
If more than one screen, show location of each on sketch

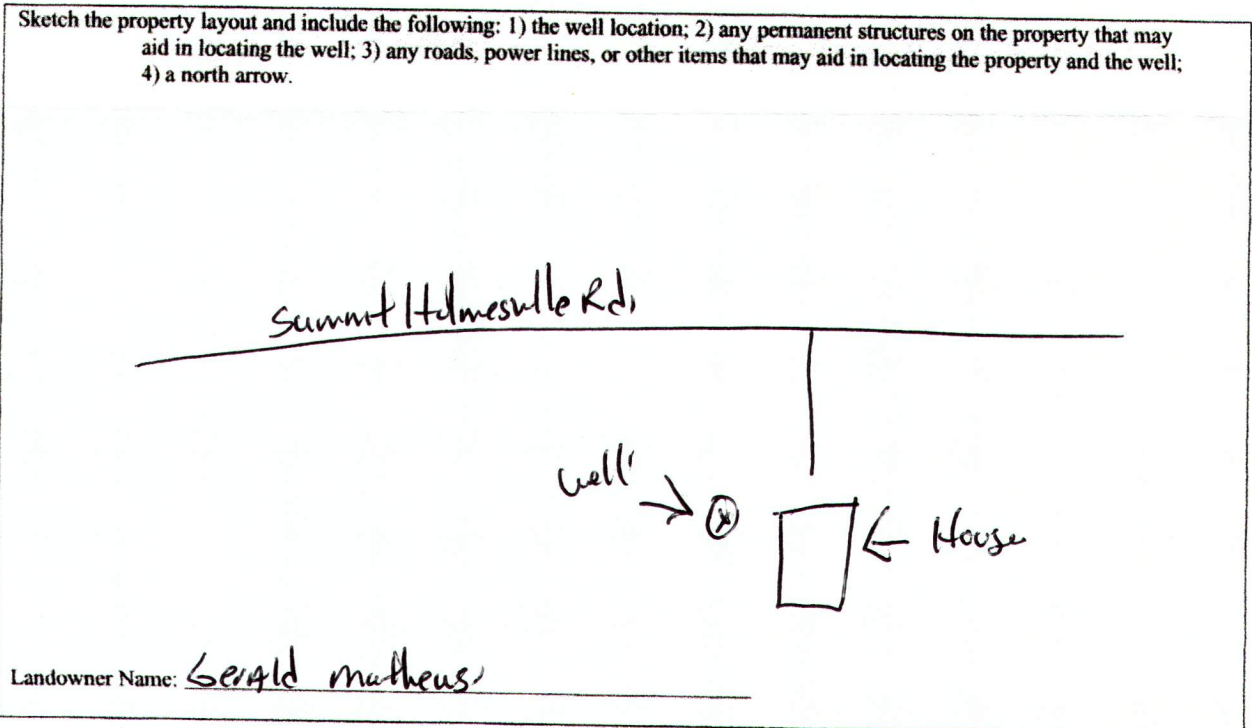

Form: OLWR-SWR-1A

I certify that the well/borehole was drilled, constructed, and completed in accordance with all applicable requirements of the Mississippi Department of Environmental Quality and the Mississippi Department of Health regulations, if applicable, and state laws.

Burd Fitzgerald 029. 4-16-06. Burd Fitzgerald

Print Name of Responsible Licensee and License No. Date Signature of Licensee

RECEIVED
APR 26 2006
BY: OLWR

STATE WELL REPORT

Part 2

Pump Installer's Completion Report
 Mississippi Department of Environmental Quality
 Office of Land and Water Resources
 P.O. Box 10631
 Jackson, MS 39289-0631
 (601)961-5210
 (601)354-6938 (fax)

County: Pike
Franklin
 Permit #: _____
 Driller: Fitzgerald Well Service
 Date completed: 4/12/06
Copy information from block on Part 1

For Office Use Only:

Aquifer: _____
 Well #: E-242
 Elevation: _____

This part of the report must be completed by a licensed water well contractor or a licensed pump installer. A copy of Part 1 of the report must be attached and both parts filed with the Department at the above address within 30 days of well completion.

| Well Owner Information | Well Location |
|--|--|
| Owner Name: <u>Gerald Matthews</u> | Latitude: _____ Longitude: _____ |
| Mailing Address: <u>Summit Holmeville Rd</u> | Method of Lat/Long (check one): Conventional Survey _____ |
| <u>McComb Ms 39648</u> | USGS quad _____ Hand-held GPS _____ Survey-grade GPS _____ |
| City State Zip Code | _____ 1/4 _____ 1/4 Sec <u>12</u> T <u>3N</u> R <u>8E</u> |
| Telephone No. (____) _____ | Distance Direction Nearest Town |
| | <u>5</u> Miles <u>East</u> of <u>McComb</u> |

| Pump Type Circle one | Power Type Circle one |
|---|---|
| Air Lift Jet <input type="radio"/> <u>Submersible</u> | Diesel Engine Gasoline Engine Natural Gas |
| Bucket Piston <input type="radio"/> Turbine <input type="radio"/> | <u>Electric Motor</u> Hand Tractor PTO |
| Centrifugal Rotary <input type="radio"/> Flowing Well <input type="radio"/> | Windmill Other (specify): _____ |
| Other (specify): _____ | Horse Power Rating of Motor: <u>3/4</u> |
| Date Pump Installed: <u>4-12-06</u> | Setting Depth: <u>93</u> feet |
| Rated Pump Capacity: <u>12</u> Gallons Per Minute | Number of Stages: <u>12</u> |

| Pump Test Data | Method of Measuring Water Level Circle one |
|--|---|
| Date Well Tested: <u>4/12/06</u> | Air Line Electric Measuring Line <u>Steel Tape</u> |
| Static Water Level (A): _____ Feet Below Land Surface | Other (specify): _____ |
| Pumping Water Level (B): _____ Feet Below Land Surface | For flowing well, measured shut in head: _____ feet |
| Drawdown [(B) - (A)]: _____ Feet Below Land Surface | Well yielded _____ GPM with a drawdown of _____ feet after _____ hours of pumping |
| Test Pumping Rate: _____ Gallons Per Minute | |
| Duration of Pump Test (minimum 4 hours): _____ hours | |

I HEREBY CERTIFY that the above statements are true to the best of my knowledge.

Brad Fitzgerald 029 Brad Fitzgerald
 Print Name of Pump Installer and License No. (if applicable) Signature of Pump Installer

Form: OLWR-SWR-18 **RECEIVED**
 APR 26 2006
 BY: OLWR