	State W	ell Report		
County: Rike	Part 1 - 1	Driller's Log	For Office Use Only:	
	Mississippi Departmen	nt of Environmental Quality	Aquifer: E 299	
Permit #:		nd Water Resources	Well #:	
Driller: Fitzgevald Well Seree		Box 2309 n, MS 39225		
10-10-11		961- 5210	L. S. Elevation:	
Date drilling completed: _10 -18-11_		1- 5228 (fax)	E-log #:	
State Law requires that this repor	t be prepared by the lic within 30 days of com	ense notaer responsible for a second se	ine work and jued with the	
Department at the above address within 30 days of con Information on Well Owner		Well or Borehole Location		
(Landowner if borehole is not for a water well)		7,0 15	60° 22' 5024	
		Latitude: <u>) ° 5 ' 0</u>	" Longitude: <u>90° 23, 58</u> 2"	
Owner Name FrANK Price Mailing Address: Summ-f Hulmain/le Roh		Method of Lat/Long (circle one): Conventional Survey,		
		USGS quad, Hand-held GPS, Survey-grade GPS		
			Twn 3N Rng 8E	
Maento mg				
City Stat	te Zip Code	Distance Direction	Nearest Town of	
Telephone No. ()		Miles	01	
	Well / Bor			
Date drilling started: 10-18-11 Date dr	illing completed: 10-18	11 Hole depth: 183	Hole diameter:	
Location of the source of any surface wate	er used for drilling:			
Method of dosing and volume of Chloring	e used in drilling and deve	lopment:		
Logs run (circle all applicable): No log run Name of organization running log(s):		Density Sonic Neutron		
Purpose of borehole (check one): Water W	ellGeotechnical/Geo	logical Investigation Ground	d Source Heat Pump	
Seismic	Survey Other (describ	e)		
If drilling is not related	to water well construction	on, skip the remainder of this b	lock	
	1			
Purpose of Well (check one): Home	ndustrial Public Suppl	y Irrigation Fish Culture	Other:	
If a flowing well, method of flow regulation	on: Valve (Other (describe)		
Static Water Level: <u>54</u> feet al	nove or below (circle one)	land surface Date measured;	10-18-11	
Method of Measurement (circle one)	electric tape			
Well depth: 183 Well grouted to a de	epth of 10 feet Typ	e of grout (circle one): Near Cer	nent Bentonite Mix	
Casing length: <u>173</u> feet Casin	ng diameter:	inches Type of casing:	puc	
Screen length:feet Scree		inches Type of screen:	pre	
Screen slot size: . 010 inches	Setting depth: From	173 feet to 18	feet	
Type of completion (circle all applicable):				
	Other (describe):			
Top of lap pipe or reduction in casing:	feet. If the	elescoped or more than one scr	een, describe on next page	

i

Form: OLWR-SWR-1A (04/0)8)
-------------------------	-----

RECEIVED OCT 3 1 2011 BY: OLWR

The sketch below only required for water wells

If well telescopes, show depths on sketch.


Ground Level_

Description of formations encountered must be provided for all wells and boreholes, unless specifically exempted by regulations

To (depth) intion of Formations Encountered From (depth)

Description of Formations Encountered		10 (aepin)
	Ground Level	
clwy-	0	20
Sruhel-	20	60
([04/	(0)	100
Cluy.		140
	198	160
Course Sand	160	183
Course	+ + + + + + + + + + + + + + + + + + + +	1.02
		1
		1
		1
		+
	+	+
	+	+ · · · · · · · · · · · · · · · · · · ·
		+
		+
		<u> </u>
	4	+
		<u> </u>
		. <u> </u>
		<u> </u>
		}

If more than one screen, show location of each on sketch

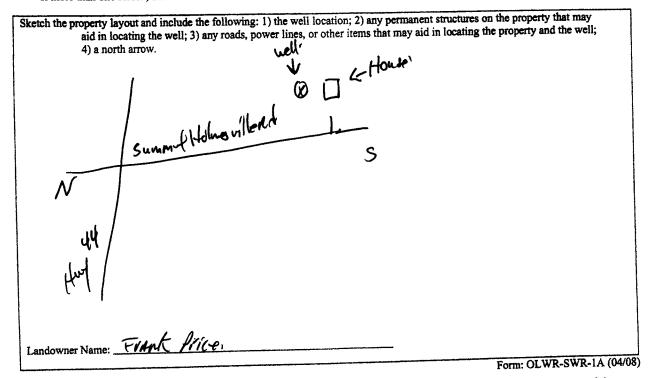

I certify that the well/borehole was drilled, constructed, and completed in accordance with all applicable requirements of the Mississippi Department of Environmental Quality and the Mississippi Department of Health regulations, if applicable, and state

10-18-11 Date

But

Print Name of Responsible Licensee and License No.

Signature of Licensee



STATE WI	ELL REPORT		
A	Part 2 For Office Use Only:		
	's Completion Report Aquifer:		
Permit #: Mississippi Departmer Driller: <u>Futzgerald Well</u> ferce P.O.	nt of Environmental Quality		
Dillar Fitziara de lut ferce Office of Land	and Water Resources Well #:		
P.O.	Box 2309 n. MS 39225 Elevation:		
Data aamalatad:	n, MS 39225 Elevation:)961-5210		
	61-5228 (fax)		
CODY MITOTIMULON NOR OUTLY ON INCL			
This part of the report must be completed by a licensed water well report must be attached and both parts filed with the Department of	contractor or a licensed pump installer. A copy of Part 1 of the at the above address within 30 days of well completion.		
Well Owner Information	W CH LOCKION		
	Latitude: 31° 15 10 Longitude: 60° 23 58.2		
Owner Name: Frank Price. Mailing Address: Summt Holmesuillow	Latitude: <u>J7 / D / O</u> Longrude: <u>/ D</u> · · · · · · · · · · · · · · · · · ·		
Sund Helmeurlock	Method of Lat/Long (check one): Conventional Survey		
Mailing Address:			
	USGS quad, Hand-held GPS, Survey-grade GPS		
A. d. La and	1/4 Sec_ 4 T_ 3N_ R 8E		
<u>M (umb MS</u> City State Zip Code			
City State Zip Code	Distance Direction Nearest Town		
Telephone No. ()	Miles of		
I DIGHTIMITE IAO.			
	Power Type		
Pump Type	Circle one		
Circle one Submersible	Diesel Engine Gasoline Engine Natural Gas		
Air Lift Jet Submersible			
Bucket Piston Turbine	Electric Motor Hand Tractor PTO		
Centrifugal Rotary Flowing Well	Windmill Other (specify):		
Other (specify):	Horse Power Rating of Motor:		
Date Pump Installed:/0 -/8 -//	Setting Depth:feet		
	Number of Stages: 12		
Rated Pump Capacity:Gallons Per Minute	INTERIOR OF STREES.		
Pump Test Data	Method of Measuring Water Level Circle one		
Date Well Tested:	Air Line Electric Measuring Line Steel Tape		
Static Water Level (A):Feet Below Land Surface			
	Other (specify):		
Pumping Water Level (B):Feet Below Land Surface			
	For flowing well, measured shut in head:feet		
Drawdown [(B) - (A)]:Feet Below Land Surface			
Test Pumping Rate:Gallons Per Minute	Well yielded GPM with a drawdown of		
	feet afterhours of pumping		
Duration of Pump Test (minimum 4 hours):hours	fect afterhours of pumping		
This is for (circle one): New Weth Replacement of E	Existing Pump Repair of Existing Pump		
I HEREBY CERTIFY that the above statements are true to the bes	at of my knowledge, 6/2		
	0 1 14/1/		
BIAS Fifterald. 029	ning		
Print Name of Pump Installer and License No. (if applicable)	Signature of Pump Installer Form: OLWR-SWR-1C (07-09)		
	Form: OLVAK-SVAR- TO ALCON		
	neueiv		
	OCT 3 1 20		
	RV- MIA		
	DY. UN		