

Pike  
E 2000  
10-27-75

MISSISSIPPI  
BOARD OF WATER COMMISSIONERS  
416 North State Street  
Jackson, Mississippi 39201


WATER WELL DRILLERS LOG

10-27 date well completed 19 75 Fitzgerald Well Sew. firm name Pike county well located

| LANDOWNER:   | description of formations encountered | from | to  |
|--|---------------------------------------|------|-----|
| Emilia Jones   | red clay                              | 0    | 20  |
| Route McComb<br>(mailing address)  | red sand                              | 20   | 70  |
| WELL LOCATION:   | Coarse sand & gravel                  | 70   | 100 |
| sec. 6 T. 3 N. R. 8 E<br>1/2 miles NE of McComb<br>(distance) (direction) (nearest town) |                                       |      |     |
| WELL PURPOSE:<br>(home, irrigation, municipal, industrial)                               |                                       |      |     |
| WELL COMPLETION DATA:  |                                       |      |     |
| (1) diameter (inches) 4"   |                                       |      |     |
| (2) total depth (feet) 100   |                                       |      |     |
| (3) static water level (feet) 65 below top of ground.                                    |                                       |      |     |
| (4) casing plastic, 92 (material) (depth)<br>4 (size) if telescope see back.             |                                       |      |     |
| (5) screen 8, 92 (length) (depth to top)   |                                       |      |     |
| (6) pump 3/4, 7 (HP) (yield gpm)   |                                       |      |     |
| Elec (type power)  |                                       |      |     |
| (7) electric log No (yes or no)  |                                       |      |     |
| (organization running log)   |                                       |      |     |
| (8) how well bottom plugged Sand Shark   |                                       |      |     |
| DRILLERS REMARKS:  | DEC 17 1975                           |      |     |

If well telescopes please sketch and show depths.

GROUND LEVEL

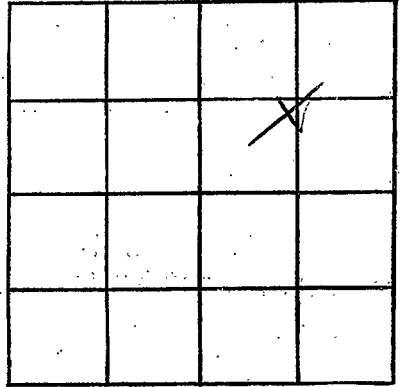

SECTION 6

Please indicate well location X.

ADDITIONAL INFORMATION

If more than one screen, show locations of each on sketch.