

Pike
E 2002
11-11-75

MISSISSIPPI
 BOARD OF WATER COMMISSIONERS
 416 North State Street
 Jackson, Mississippi 39201

WATER WELL DRILLERS LOG

Nov 11 1975 Annex Well Drilling Pike
 date well completed firm name county well located

LANDOWNER:
Marvin Ball-
Rt 1 Mc Comb
 (mailing address)

description of formations encountered	from	to
<u>Sandy clay</u>	<u>0</u>	<u>6</u>
<u>loosely</u>	<u>6</u>	<u>40</u>
<u>crack sand</u>	<u>41</u>	<u>71</u>

WELL LOCATION:
 sec. 19 T. 3 N. R. 8 E
1 miles East of McComb
 (distance) (direction) (nearest town)

WELL PURPOSE: Home
 (home, irrigation, municipal, industrial)


- WELL COMPLETION DATA:
- (1) diameter (inches) 4"
 - (2) total depth (feet) 71
 - (3) static water level (feet) 10 below above top of ground.
 - (4) casing Plastic, bottom
 (material) (depth)
 - If telescope see back.
 (size)
 - (5) screen 6', 65'
 (length) (depth to top)
 - 1 1/2", Plastic
 (size) (material)
 - (6) pump 1/2 HP, 5
 (HP) (yield gpm)
 - elect
 (type power)
 - (7) electric log no
 (yes or no)
 - (organization running log)
 - (8) how well bottom plugged
Woodchipping

DRILLERS REMARKS:
7" well cement
bad

DEC 20 1975
 JAN 12 1976
 MISS. BD. OF WATER COMMISSIONERS

If well telescopes please sketch and show depths.

GROUND LEVEL

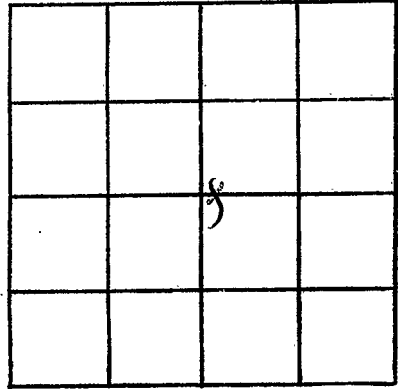

SECTION 19

Please indicate well location X.

ADDITIONAL INFORMATION

If more than one screen,
show locations of each on sketch.