

Pike
 E 2003
 2/14/76

MISSISSIPPI
 BOARD OF WATER COMMISSIONERS
 416 North State Street
 Jackson, Mississippi 39201

WATER WELL DRILLERS LOG

Feb-14 1976 Revere well Service, Pipe
 date well completed firm name county well located

LANDOWNER:
 Phillip McKennzie
 Rt 1 McCombs
 (mailing address)

description of formations encountered	from	to
Clay & Gravel	0	30
Red sand	30	70
small gravel & sand	70	81


WELL LOCATION:
 sec. 32 T-3 N R-8 E
 S E W E
 1 miles east of Fernand
 (distance) (direction) (nearest town)

WELL PURPOSE: home
 (home, irrigation, municipal, industrial)

- WELL COMPLETION DATA:
- (1) diameter (inches) 4"
 - (2) total depth (feet) 81
 - (3) static water level (feet) 45 below top of ground.
 - (4) casing plastic, bottom (material) (depth)
 - (size) If telescope see back.
 - (5) screen 6' 75 (length) (depth to top)
 - (size) 4" plastic (material)
 - (6) pump 1/2 Sub 1.0 (HP) (yield gpm)
 - (type power) elect
 - (7) electric log NO (yes or no)
 - (organization running log)


(8) how well bottom plugged
 wooden plug

DRILLERS REMARKS:
 no Remark -

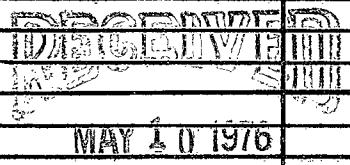

If well telescopes please sketch and show depths.

GROUND LEVEL

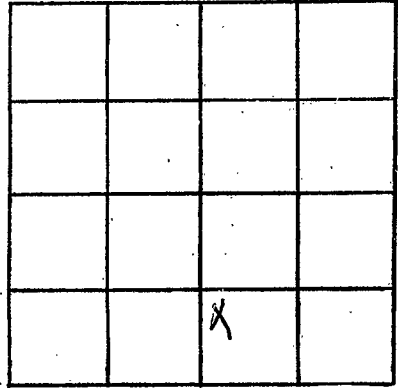

SECTION 32

Please indicate well location X.

ADDITIONAL INFORMATION

If more than one screen, show locations of each on sketch.