

Pike
E 2004
2-27-76

MISSISSIPPI
BOARD OF WATER COMMISSIONERS
416 North State Street
Jackson, Mississippi 39201


WATER WELL DRILLERS LOG

Feb 27 1976
date well completed

14H
Premier Well Service Pipe
firm name


county well located

LANDOWNER:		description of formations encountered	from	to
Carlton Blake Rt 2 McComb (mailing address)				
WELL LOCATION:		Sand & gravel	18	60
sec. 33 T. 3 N R. 8 E S W		pink Chalk	60	90
3 miles east of Farmington (distance) (direction) (nearest town)		Sand & gravel	70	93
WELL PURPOSE: none (home, irrigation, municipal, industrial)				
WELL COMPLETION DATA:				
(1) diameter (inches)	4 4"			
(2) total depth (feet)	93			
(3) static water level (feet)	60 below top of ground.			
(4) casing (material)	plastic			
(4) casing (depth)	bottom			
(5) screen (length)	6'			
(5) screen (depth to top)	77			
(6) pump (HP)	1/2			
(6) pump (yield gpm)	10			
(7) electric log (yes or no)	no			
(8) how well bottom plugged	wooden			
DRILLERS REMARKS: new location				

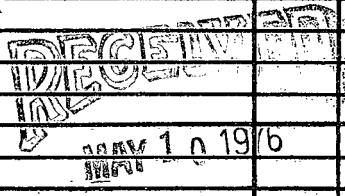

If well telescopes please sketch and show depths.

GROUND LEVEL

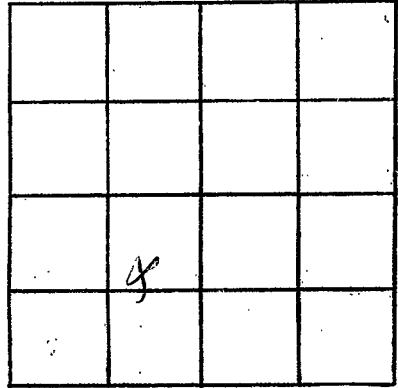

SECTION 33

Please indicate well location X.

ADDITIONAL INFORMATION

If more than one screen, show locations of each on sketch.