

Pike
E 2005
4-5-76

MISSISSIPPI
BOARD OF WATER COMMISSIONERS
416 North State Street
Jackson, Mississippi 39201

WATER WELL DRILLERS LOG

April 5 1976 Reeves Well Ser. Pike
date well completed firm name county well located

LANDOWNER:
Mrs. Ollie Allen
Rt. 1, M^o 1, Combe -
(mailing address)

description of formations encountered	from	to
Red Clay	0	20
sand & gravel	20	60
white chalk	60	80
sand & gravel	80	90

WELL LOCATION:
sec. 33 T 3 N R 8 E
2 miles SE of Fernand
(distance) (direction) (nearest town)

WELL PURPOSE: house
(home, irrigation, municipal, industrial)

WELL COMPLETION DATA:
(1) diameter (inches) 4"
(2) total depth (feet) 90
(3) static water level (feet) 70 below top of ground.
(4) casing Plastic bottom
(material) (depth)
(size) If telescope see back.
(5) screen 6" 84"
(length) (depth to top)
4" plastic
(size) (material)
(6) pump 1/2 Sub 10
(HP) (yield gpm)
elect
(type power)
(7) electric log NO
(yes or no)
(organization running log)


(8) how well bottom plugged
Wooden plug
DRILLERS REMARKS:
new house

RECEIVED
ALL

JUL 6 1976

If well telescopes please sketch and show depths.

GROUND LEVEL

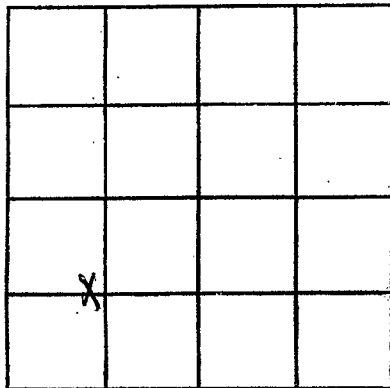

SECTION 33

Please indicate well location X.

ADDITIONAL INFORMATION

If more than one screen, show locations of each on sketch.