

Pike
 E 2000
 4-7-76

MISSISSIPPI
 BOARD OF WATER COMMISSIONERS
 416 North State Street
 Jackson, Mississippi 39201

WATER WELL DRILLERS LOG


4-7-76 134 26 Floyd Well Service Pike
 date well completed firm name county well located

LANDOWNER:	description of formations encountered	from	to
<u>Alvin Fortenberry</u>			
<u>R.R. McComb, Miss.</u> (mailing address)	<u>Red clay</u>	<u>0</u>	<u>20</u>
	<u>Red gravel</u>	<u>20</u>	<u>80</u>
	<u>Red sand & gravel</u>	<u>80</u>	<u>120</u>
	<u>Coarse sand & gravel</u>	<u>120</u>	<u>128</u>

1111
 1976
 MISS. DEPT. OF WATER

If well telescopes please sketch and show depths.

GROUND LEVEL

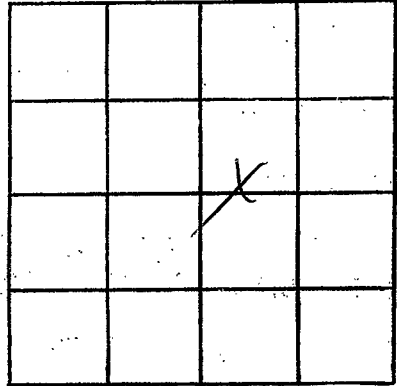

SECTION 1A

Please indicate well location X.

ADDITIONAL INFORMATION

If more than one screen, show locations of each on sketch.