

Pike
E 2007
July 6, 1976

MISSISSIPPI
 BOARD OF WATER COMMISSIONERS
 416 North State Street
 1374 Jackson, Mississippi 39201

WATER WELL DRILLERS LOG

7/6/76 19 Ann Park Well Co. Pike
 date well completed firm name county well located

LANDOWNER:
Albert James
McComb
 (mailing address)

WELL LOCATION:
 sec 36 T 3 N R 8 E
6 miles E of McComb
 (distance) (direction) (nearest town)

WELL PURPOSE:
 (home, irrigation, municipal, industrial)

WELL COMPLETION DATA:
 (1) diameter (inches) 4
 (2) total depth (feet) 147
 (3) static water level (feet) 120 below above top of ground.
 (4) casing PI 141
 (material) (depth)
 (size) If telescope see back.
 (5) screen 6 141
 (length) (depth to top)
4 PI
 (size) (material)
 (6) pump 1/2 8
 (HP) (yield gpm)
split
 (type power)
 (7) electric log yes or no
 (organization running log)
 (8) how well bottom plugged wood

description of formations encountered	from	to
<u>Clay</u>	<u>10</u>	<u>25</u>
<u>Salt sub</u>	<u>25</u>	<u>40</u>
<u>Brack</u>	<u>40</u>	<u>75</u>
<u>sub</u>	<u>75</u>	<u>120</u>
<u>grnd</u>	<u>120</u>	<u>147</u>


DRILLERS REMARKS:

RECEIVED
 SEP - 1 1976

MISS. BD. OF WATER COMMISSIONERS

If well telescopes please sketch and show depths.

GROUND LEVEL

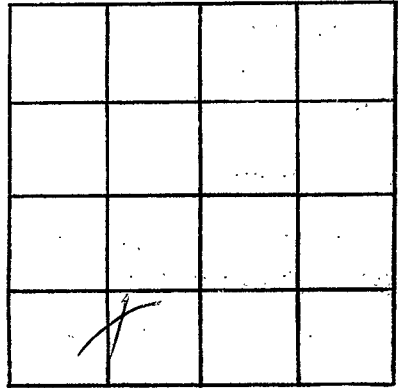

SECTION

36

Please indicate well location X.

ADDITIONAL INFORMATION

If more than one screen, show locations of each on sketch.