

Pike
 E 2007
 12-17-76

MISSISSIPPI
 BOARD OF WATER COMMISSIONERS
 416 North State Street
 Jackson, Mississippi 39201

WATER WELL DRILLERS LOG

Dec 17 1976 Reussman Ser. Pike
 date well completed firm name county well located

LANDOWNER:
J. H. Sonny Marshall
Attn. McComb
 (mailing address)

WELL LOCATION:
 sec. 5 T. 3 N. R. 8 E
1 miles east of McComb
 (distance) (direction) (nearest town)

WELL PURPOSE: pond
 (home, irrigation, municipal, industrial)

WELL COMPLETION DATA:
 (1) diameter (inches) 4"
 (2) total depth (feet) 224
 (3) static water level (feet) 102 below above top of ground.
 (4) casing plastic bottom
 (material) (depth)
 (size) if telescope see back.
 (5) screen 16' 212
 (length) (depth to top)
4" plastic
 (size) (material)
 (6) pump Diaphragm 100
 (HP) (yield gpm)...
elect
 (type power)
 (7) electric log no
 (yes or no)
 (organization running log)

description of formations encountered	from to	
<u>Red clay</u>	<u>0</u>	<u>25</u>
<u>Red sand</u>	<u>25</u>	<u>60</u>
<u>sand & gravel</u>	<u>60</u>	<u>71</u>
<u>white chalk</u>	<u>71</u>	<u>190</u>
<u>fine sand</u>	<u>190</u>	<u>210</u>
<u>fine gravel & sand</u>	<u>210</u>	<u>224</u>


(8) how well bottom plugged
wood plug
 DRILLERS REMARKS:

RECEIVED
 FEB - 7 1977

MISS. RD. OF WATER COMMISSIONERS

If well telescopes please sketch and show depths.

GROUND LEVEL

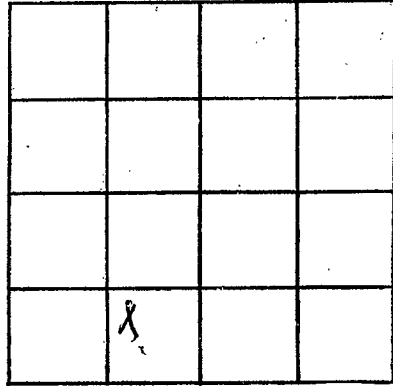

SECTION 5

Please indicate well location X.

ADDITIONAL INFORMATION

If more than one screen, show locations of each on sketch.