

Pibe
 E 2010
 6-13-77

MISSISSIPPI
 BOARD OF WATER COMMISSIONERS
 416 North State Street
 Jackson, Mississippi 39201

WATER WELL DRILLERS LOG

6-13 date well completed 19 77 firm name Pibe county well located

LANDOWNER:
 Georgia Doughty
 R.R. 2466 Miss.
 (mailing address)

| description of formations encountered | from | to |
|---------------------------------------|------|-----|
| Red clay | 0 | 20 |
| Red sil | 20 | 110 |
| Coarse sand & gravel | 110 | 117 |

WELL LOCATION:
 sec. 6 T 30 N S R 8 E W
 1/4 miles E of 2466
 (distance) (direction) (nearest town)

WELL PURPOSE:
 Home
 (home, irrigation, municipal, industrial)

- WELL COMPLETION DATA:
- (1) diameter (inches) 4
 - (2) total depth (feet) 117
 - (3) static water level (feet) 80 below top of ground.
 - (4) casing PVC 109 (material), (depth)
 4 (size) if telescope see back.
 - (5) screen 8 (length), 109 (depth to top)
 4 (size), PVC (material)
 - (6) pump 1/2 (HP), 10 (yield gpm)
 elec (type power)
 - (7) electric log yes (yes or no)
 (organization running log)
 - (8) how well bottom plugged full back


DRILLERS REMARKS:

RECEIVED

JUN 29 1977

If well telescopes please sketch and show depths.

GROUND LEVEL

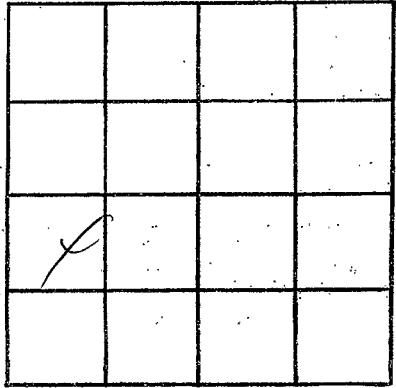

SECTION 6

Please indicate well location X.

ADDITIONAL INFORMATION

If more than one screen,
show locations of each on sketch.