

Pike  
E 200  
8/4/77

MISSISSIPPI  
BOARD OF WATER COMMISSIONERS  
416 North State Street  
Jackson, Mississippi 39201

8 logs

WATER WELL DRILLERS LOG

Aug. 4 1977 77 Brumfield Well Serv. Pike  
date well completed firm name county well located

LANDOWNER: Reboid  
McComb miss

description of formations encountered

from to

	CLAY	0	16
	SANDY CLAY	16	30
	GRAVEL	30	55
	WATER SAND & ROCK	55	77

(mailing address)

WELL LOCATION:  
sec. 28 T. 3 N R. 8 E  
3 miles S.E. of McComb  
(distance) (direction) (nearest town)

WELL PURPOSE: Domestic  
(home, irrigation, municipal, industrial)

- WELL COMPLETION DATA:
- (1) diameter (inches) 4
  - (2) total depth (feet) 75
  - (3) static water level (feet) 55 below above top of ground.
  - (4) casing PLASTIC, 65  
(material) (depth)  
4" If telescope see back.  
(size)
  - (5) screen 10', 65  
(length) (depth to top)  
4, PLASTIC  
(size) (material)
  - (6) pump 1/2, 8  
(HP) (yield gpm)  
elec  
(type power)
  - (7) electric log   
(yes or no)

(organization running log)

(8) how well bottom plugged wood


DRILLERS REMARKS:

RECEIVED  
NOV - 2 1977

MISS. BB. OF WATER COMMISSIONERS

If well telescopes please sketch and show depths.

GROUND LEVEL

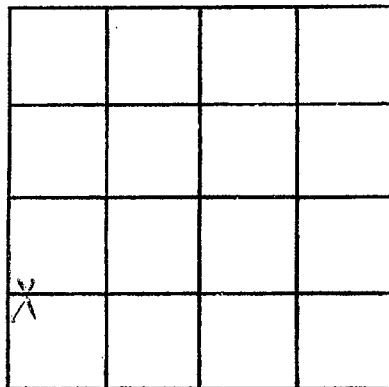

SECTION 28

Please indicate well location X.

ADDITIONAL INFORMATION

If more than one screen, show locations of each on sketch.