

PIKE  
E 2012  
9/13/77

MISSISSIPPI  
BOARD OF WATER COMMISSIONERS  
416 North State Street  
Jackson, Mississippi 39201

122

WATER WELL DRILLERS LOG

9-13 1977 Reena Walker Pike  
date well completed firm name county well located

LANDOWNER:	description of formations encountered	from	to
<u>George Long</u> <u>Rt 1 box 108 - A McComb</u> (mailing address)	<u>Clay</u> <u>Chalky sand</u> <u>sand &amp; gravel</u>	<u>0</u> <u>20</u> <u>55</u>	<u>20</u> <u>55</u> <u>71</u>
WELL LOCATION:			
sec. <u>5</u> T. <u>3</u> N R. <u>8</u> E			
<u>2</u> miles <u>east</u> of <u>McComb</u> (distance) (direction) (nearest town)			
WELL PURPOSE: <u>Trailer</u> (home, irrigation, municipal, industrial)			
WELL COMPLETION DATA:			
(1) diameter (inches) <u>4"</u>			
(2) total depth (feet) <u>71'</u>			
(3) static water level (feet) <u>55'</u> below top of ground.			
(4) casing <u>plastic</u> , <u>bottom</u> (material) (depth)			
<u>✓</u> If telescope see back. (size)			
(5) screen <u>5'</u> , <u>bottom</u> (length) (depth to top)			
<u>4"</u> <u>plastic</u> (size) (material)			
(6) pump <u>1/2 hp</u> , <u>10</u> (HP) (yield gpm)			
<u>elect</u> (type power)			
(7) electric log <u>no</u> (yes or no)			
<u>✓</u> (organization running log)			
(8) how well bottom plugged <u>wooden plug</u>			
DRILLERS REMARKS:			


RECEIVED

FEB 21 1978

MISS. BD. OF WATER COMM.

If well telescopes please  
sketch and show depths.

GROUND LEVEL

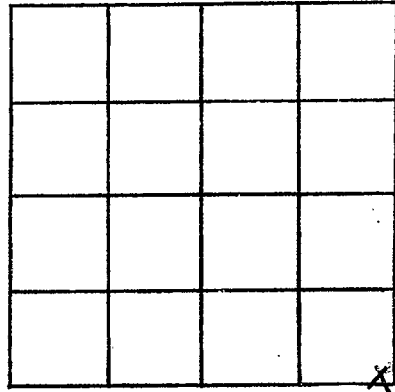

SECTION 5

Please indicate well location X.

ADDITIONAL INFORMATION

If more than one screen,  
show locations of each on sketch.