

PIKE

2013 E

5/5/78

MISSISSIPPI BOARD OF WATER COMMISSIONERS
416 North State Street
Jackson, Mississippi 39201

WATER WELL DRILLERS LOG

May 5
date well completed

1978 Newsnullsen
firm name

Pike
county well located


LANDOWNER:	description of formations encountered	from	to
James Conley Jr Rt 2 McConde (mailing address)	Red sandy clay Red sand & gravel pink chalk gravel & sand	22 22 68 76	22 68 76 90
WELL LOCATION:			
sec. 34 T 3 N R 8 E			
5 miles ESE of McConde (distance) (direction) (nearest town)			
WELL PURPOSE: home (home, irrigation, municipal, industrial)			
WELL COMPLETION DATA:			
(1) diameter (inches) 4"			
(2) total depth (feet) 90			
(3) static water level (feet) 75 below top of ground.			
(4) casing plastic, bottom (material) (depth)			
If telescope see back. (size)			
(5) screen 5' 85' (length) (depth to top)			
4" plastic (size) (material)			
(6) pump 1/2 sub 10 (HP) (yield gpm)			
electric (type power)			
(7) electric log no (yes or no)			
(organization running log)			
(8) how well bottom plugged wooden plug			
DRILLERS REMARKS:			

RECEIVED
JUN 26 1978

MISS. BD. OF WATER COMM

If well telescopes please sketch and show depths.

GROUND LEVEL

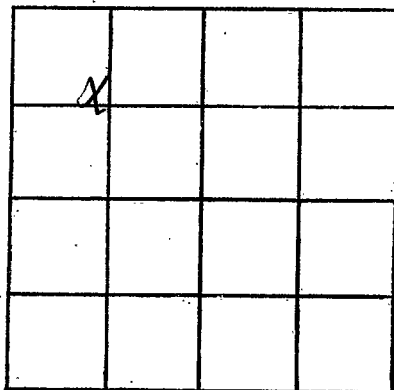

SECTION 34

Please indicate well location X.

ADDITIONAL INFORMATION

If more than one screen,
show locations of each on sketch.