

PIKE  
E 2014  
8-24-78

MISSISSIPPI  
BOARD OF WATER COMMISSIONERS  
416 North State Street  
Jackson, Mississippi 39201

WATER WELL DRILLERS LOG

8-24-78 19 ~~East Burrefield~~ Pike  
date well completed firm name county well located  
Fitzgerald Well Serv.

LANDOWNER:  
East Burrefield  
R.R. McComb  
(mailing address)

description of formations encountered	county well located	
	from	to
<u>Red clay</u>	<u>0</u>	<u>20</u>
<u>Red sand</u>	<u>20</u>	<u>80</u>
<u>Coarse sandstone</u>	<u>80</u>	<u>136</u>

WELL LOCATION:  
sec. 23 T 3 N R 8 E  
S W  
6 miles E of McComb  
(distance) (direction) (nearest town)

WELL PURPOSE: drinking  
(home, irrigation, municipal, industrial)


- WELL COMPLETION DATA:
- (1) diameter (inches) 4
  - (2) total depth (feet) 136
  - (3) static water level (feet) 100 below above top of ground.
  - (4) casing PVC, 128,  
(material) (depth)  
4 if telescope see back.  
(size)
  - (5) screen 8, 128  
(length) (depth to top)  
4, PVC  
(size) (material)
  - (6) pump 1/2, 10  
(HP) (yield gpm)  
Ele  
(type power)
  - (7) electric log no  
(yes or no)
  - (8) how well bottom plugged Lead Hook

DRILLERS REMARKS:

RECEIVED  
OCT 9 1978

If well telescopes please sketch and show depths.

GROUND LEVEL

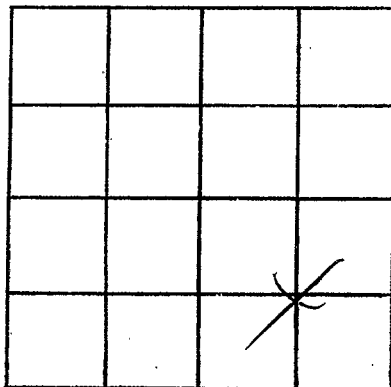

SECTION 23

Please indicate well location X.

ADDITIONAL INFORMATION

If more than one screen, show locations of each on sketch.