

PIKE  
E 2016  
7-23-78

MISSISSIPPI  
BOARD OF WATER COMMISSIONERS  
416 North State Street  
Jackson, Mississippi 39201

WATER WELL DRILLERS LOG

July 23 1978 *Reems Well Co* *Pike*  
date well completed firm name county well located

LANDOWNER: *Mr. Chester Reems Jr.*  
*P.O. box 160 McCook*  
(mailing address)

description of formations encountered	from	to
<i>Red Clay</i>	<i>0</i>	<i>17</i>
<i>Red sand</i>	<i>17</i>	<i>52</i>
<i>Plastic</i>	<i>52</i>	<i>56</i>
<i>hard gravel</i>	<i>56</i>	<i>79</i>

WELL LOCATION:  
sec. *10* T. *3* N R. *8* E  
*3 1/2* miles east of *McCook*  
(distance) (direction) (nearest town)

WELL PURPOSE: *Fish pond*  
(home, irrigation, municipal, industrial)

WELL COMPLETION DATA:

(1) diameter (inches) *4"*

(2) total depth (feet) *79*

(3) static water level (feet) *57* below above top of ground.

(4) casing *plastic bottom*  
(material) (depth)

*—* If telescope see back.  
(size)

(5) screen *10'* *69'*  
(length) (depth to top)

*4"* *plastic*  
(size) (material)

(6) pump *1 1/2* *30*  
(HP) (yield gpm)


*split*  
(type power)

(7) electric log *no*  
(yes or no)

*—*  
(organization running log)

(8) how well bottom plugged  
*wood chips*


DRILLERS REMARKS:  
*[Signature]*

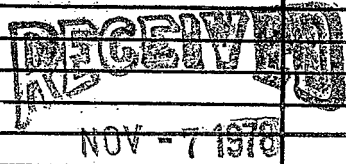

MISS. BD. OF WATER COM.

If well telescopes please sketch and show depths.

GROUND LEVEL

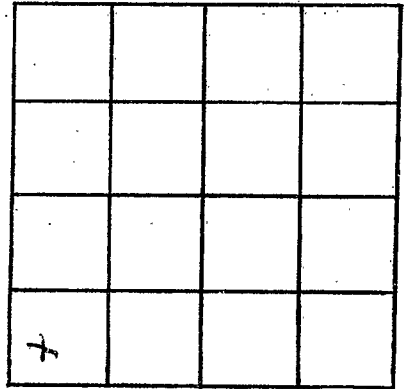

SECTION 10

Please indicate well location X.

ADDITIONAL INFORMATION

If more than one screen,  
show locations of each on sketch.