

PIKE
 E 2017
 10-04-78

MISSISSIPPI
 BOARD OF WATER COMMISSIONERS
 416 North State Street
 Jackson, Mississippi 39201

WATER WELL DRILLERS LOG

Oct 4 1978 *Reynolds* *Pike*
 date well completed firm name county well located

LANDOWNER:
Halton Washington
Rt 1 McComb
 (mailing address)

WELL LOCATION:
 sec. *17* T *3* N R *8* E
2 miles *east* of *McComb*
 (distance) (direction) (nearest town)

WELL PURPOSE: *home*
 (home, irrigation, municipal, industrial)

WELL COMPLETION DATA:

(1) diameter (inches) *4"*

(2) total depth (feet) *125'*

(3) static water level (feet) *91'* below
 top of ground.

(4) casing *plastic, bottom*
 (material) (depth)

(size) if telescope see back.

(5) screen *5"*, *120'*
 (length) (depth to top)

4", *plastic*
 (size) (material)

(6) pump *1/2 hp*, *10*
 (HP) (yield gpm)

elect
 (type power)

(7) electric log *no*
 (yes or no)

(organization running log)

description of formations encountered	from	to
<i>Red Clay</i>	<i>0</i>	<i>20</i>
<i>Red sand</i>	<i>20</i>	<i>70</i>
<i>small gravel & chert</i>	<i>70</i>	<i>105</i>
<i>lumpy sand</i>	<i>105</i>	<i>115</i>
<i>Coarse sand & gravel</i>	<i>115</i>	<i>125</i>

(8) how well bottom plugged
wooden plug

DRILLERS REMARKS:


Miss. Board of Water Comm.

1978

RECEIVED

If well telescopes please sketch and show depths.

GROUND LEVEL

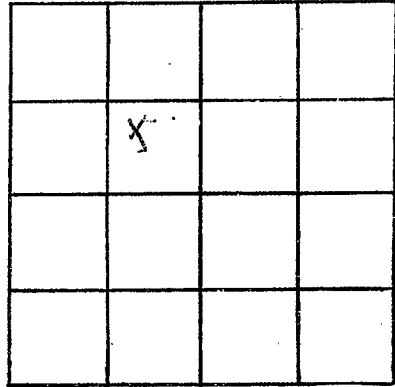

SECTION 17

Please indicate well location X.

ADDITIONAL INFORMATION

If more than one screen, show locations of each on sketch.