

Pike
E 2018
4-26-79

MISSISSIPPI
BOARD OF WATER COMMISSIONERS
416 North State Street
Jackson, Mississippi 39201

WATER WELL DRILLERS LOG

4-26 1979 *Fitzgerald* *Pike*
date well completed firm name county well located

LANDOWNER:
Dale Denaway
R.R. McComb
(mailing address)

description of formations encountered	from	to
<i>Red clay</i>	<i>0</i>	<i>20</i>
<i>Red sand</i>	<i>20</i>	<i>60</i>
<i>white chalk</i>	<i>60</i>	<i>120</i>
<i>Coarse sand & gravel</i>	<i>120</i>	<i>139</i>

WELL LOCATION:
sec. 1 T 3 N R 8 E
S W
6 miles E of McComb
(distance) (direction) (nearest town)

WELL PURPOSE: Home
(home, irrigation, municipal, industrial)


- WELL COMPLETION DATA:
- (1) diameter (inches) 4
 - (2) total depth (feet) 139
 - (3) static water level (feet) 60 below top of ground.
 - (4) casing PVC, 131,
(material) (depth)
4 if telescope see back.
(size)
 - (5) screen 8, 131
(length) (depth to top)
4, PVC
(size) (material)
 - (6) pump 1/2, 10
(HP) (yield gpm)
Che
(type power)
 - (7) electric log no
(yes or no)
(organization running log)
 - (8) how well bottom plugged Sealed

DRILLERS REMARKS:

Miss. Board of Water Comm.
MAY 30 1979
RECEIVED

If well telescopes please sketch and show depths.

GROUND LEVEL

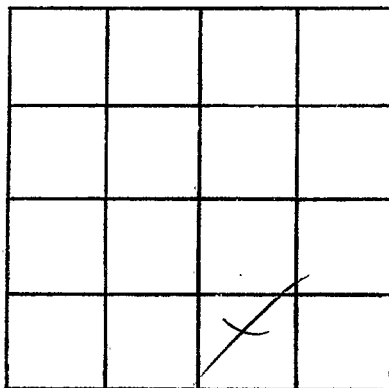

SECTION 1

Please indicate well location X.

ADDITIONAL INFORMATION

If more than one screen, show locations of each on sketch.