

Pike  
E 2019  
8-31-79

MISSISSIPPI  
BOARD OF WATER COMMISSIONERS  
416 North State Street  
Jackson, Mississippi 39201

WATER WELL DRILLERS LOG

8-31

1979 Fitzgerald Well Dr

Pike

date well completed

firm name

county well located

LANDOWNER:	description of formations encountered	from	to
Percy McKenzie	Red clay	0	20
P.B. McComb (mailing address)	Red sand	20	60
WELL LOCATION:	Red gravel	60	90
sec. <u>8</u> T <u>3</u> N R <u>8</u> E S W <u>2</u> miles <u>E</u> of <u>McComb</u> (distance) (direction) (nearest town)	Cave sand & gravel	90	100
WELL PURPOSE: (home, irrigation, municipal, industrial)			
WELL COMPLETION DATA:			
(1) diameter (inches) <u>4</u>			
(2) total depth (feet) <u>100</u>			
(3) static water level (feet) <u>75</u> below top of ground. above			
(4) casing <u>PVC 92</u> (material) (depth) <u>4</u> if telescope see back. (size)			
(5) screen <u>8 92</u> (length) (depth to top) <u>4</u> (size) <u>PVC</u> (material)			
(6) pump <u>1/2 10</u> (HP) (yield gpm) <u>Electric</u> (type power)			
(7) electric log <u>yes</u> (yes or no)			
(organization running log)			
(8) how well bottom plugged <u>Sand block</u>			
DRILLERS REMARKS:			


Miss. Board of Water Comm.

SEP 12 1979

RECEIVED

If well telescopes please sketch and show depths.

GROUND LEVEL

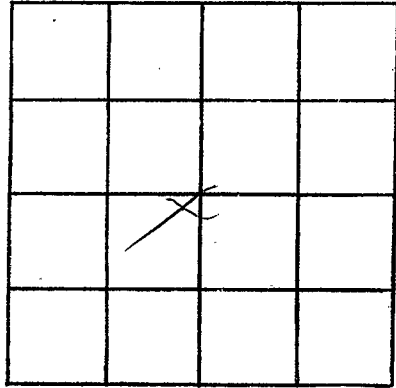

SECTION 8

Please indicate well location X.

ADDITIONAL INFORMATION

If more than one screen, show locations of each on sketch.