

MISSISSIPPI DEPARTMENT OF NATURAL RESOURCES

Bureau of Land and Water Resources

Southport Mall

P.O. Box 10631

Jackson, Mississippi 39209

WATER WELL DRILLERS LOG

PIKE
E 2020
10-22-79

Oct 22 1979
date well completed

Reems Well Ser
firm name

Pike
county well located

LANDOWNER:	description of formations encountered	from	to
Carl Kirkbaldell			
P. D. boy McComb (mailing address)	Clay + gravel Red sand + clay Gravel + sand	0 20 82	20 82 103
WELL LOCATION:			
sec. <u>19</u> T. <u>3</u> N. R. <u>8</u> E			
1 miles <u>east</u> of <u>McComb</u> (distance) (direction) (nearest town)			
WELL PURPOSE: <u>house</u> (home, irrigation, municipal, industrial)			
WELL COMPLETION DATA:			
(1) diameter (inches) <u>4"</u>			
(2) total depth (feet) <u>103</u>			
(3) static water level (feet) <u>75</u> below top of ground. <u>above</u>			
(4) casing <u>plastic bottom</u> (material) (depth)			
<u> </u> if telescope see back. (size)			
(5) screen <u>5'</u> <u>98'</u> (length) (depth to top)			
<u>4"</u> <u>plastic</u> (size) (material)			
(6) pump <u>Waters</u> (HP) (yield gpm)			
<u>slut</u> (type power)			
(7) electric log <u>no</u> (yes or no)			
<u> </u> (organization running log)			
(8) how well bottom plugged <u>water plug</u>			
DRILLERS REMARKS: <u> </u>			


DEPT. OF NATURAL RESOURCES
BUREAU OF LAND & WATER RESOURCES

OCT - 9 1980

RECEIVED

If well telescopes please sketch and show depths.

GROUND LEVEL

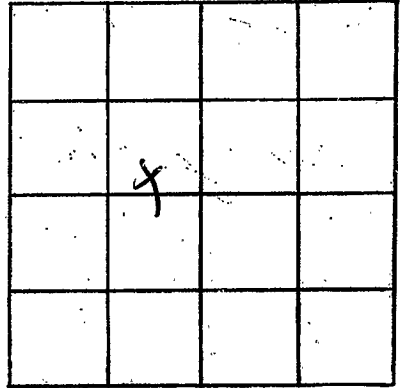

SECTION 17

Please indicate well location X.

ADDITIONAL INFORMATION

If more than one screen,
show locations of each on sketch.