

Pike

E 2023

5-27-80

5-27

date well completed

MISSISSIPPI
 BOARD OF WATER COMMISSIONERS
 416 North State Street
 Jackson, Mississippi 39201

WATER WELL DRILLERS LOG

19

80

firm name

county well located

Fitzwell Well Dr. Pike

LANDOWNER:

Bessie Wilkins

R.R. McComb
(mailing address)

description of formations encountered

from

to

Red clay
above sand ground

0 20
20 47

WELL LOCATION:

sec. 36 T 3 N R 8 E
S W
2 miles W of Bata
(distance) (direction) (nearest town)

WELL PURPOSE:

home
(home, irrigation, municipal, industrial)

WELL COMPLETION DATA:

- (1) diameter (inches) 4
- (2) total depth (feet) 47
- (3) static water level (feet) 20 below above top of ground.
- (4) casing PVC 39 (material) (depth)
4 (size) if telescope see back.
- (5) screen 8 39 (length) (depth to top)
4 (size) PVC (material)
- (6) pump 1/2 10 (HP) (yield gpm)
Elex (type power)
- (7) electric log No (yes or no)
(organization running log)
- (8) how well bottom plugged sand

DRILLERS REMARKS:


DEPT. OF NATURAL RESOURCES
BUREAU OF LAND & WATER

JUN 20 1980

RECEIVED

If well telescopes please sketch and show depths.

GROUND LEVEL

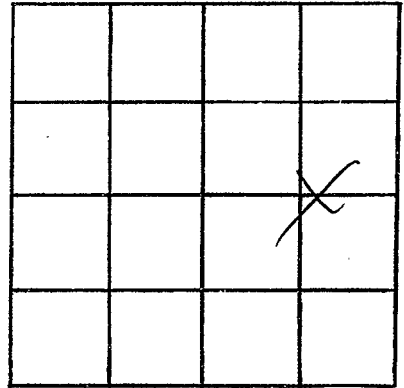

SECTION _____

Please indicate well location X.

ADDITIONAL INFORMATION

If more than one screen,
show locations of each on sketch.