

Pike
 E 2027
 9-8-80

MISSISSIPPI
 BOARD OF WATER COMMISSIONERS
 416 North State Street
 Jackson, Mississippi 39201

WATER WELL DRILLERS LOG

9-8 1980 Fitzgibbon Well Serv Pike
 date well completed firm name county well located

LANDOWNER:
Eddie Hightower
RR 2 McComb Miss.
 (mailing address)

description of formations encountered	from	to
<u>Red clay</u>	<u>0</u>	<u>20</u>
<u>Red sand & gravel</u>	<u>20</u>	<u>105</u>
<u>White & blue clay</u>	<u>105</u>	<u>220</u>
<u>Coarse sand</u>	<u>220</u>	<u>235</u>

WELL LOCATION:
 sec. 14 T. 3 N R. 8 E
 S W
6 miles E of McComb
 (distance) (direction) (nearest town)

WELL PURPOSE: Home
 (home, irrigation, municipal, industrial)

- WELL COMPLETION DATA:
- (1) diameter (inches) 4
 - (2) total depth (feet) 235
 - (3) static water level (feet) 110 below above top of ground.
 - (4) casing PVC 227
 (material) (depth)
4 If telescope see back.
 (size)
 - (5) screen 8 227
 (length) (depth to top)
4 PVC
 (size) (material)
 - (6) pump 12 10
 (HP) (yield gpm)
electric
 (type power)
 - (7) electric log 24
 (yes or no)
- (organization running log)
- (8) how well bottom plugged Sand plug

DEPT. OF NATURAL RESOURCES
 BUREAU OF LAND & WATER RESOURCES


DEC - 9 1980

RECEIVED

DRILLERS REMARKS:

If well telescopes please sketch and show depths.

GROUND LEVEL

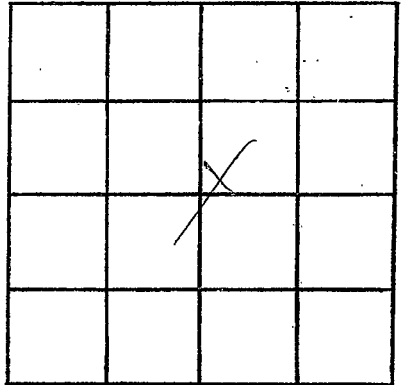

SECTION 14

Please indicate well location X.

ADDITIONAL INFORMATION

If more than one screen, show locations of each on sketch.