

PIKE
E 2028
11-25-80

MISSISSIPPI
 BOARD OF WATER COMMISSIONERS
 416 North State Street
 Jackson, Mississippi 39201

WATER WELL DRILLERS LOG

11-25 1980 Fitzgerald Well Serv Pike
 date well completed firm name county well located

LANDOWNER:	description of formations encountered	from	to
<u>Wanda McCoy</u>	<u>Red Clay</u>	<u>0</u>	<u>20</u>
<u>RR 2, McClumb</u> (mailing address)	<u>Red sand</u>	<u>20</u>	<u>60</u>
WELL LOCATION:	<u>Blue chalk</u>	<u>60</u>	<u>140</u>
sec <u>27</u> T <u>3</u> <u>N</u> R <u>8</u> <u>E</u>	<u>Coarse sandstone</u>	<u>140</u>	<u>154</u>
<u>5</u> miles <u>E</u> of <u>McClumb</u> (distance) (direction) (nearest town)			
WELL PURPOSE: <u>Home</u> (home, irrigation, municipal, industrial)			
WELL COMPLETION DATA:			
(1) diameter (inches) <u>4</u>			
(2) total depth (feet) <u>154</u>			
(3) static water level (feet) <u>60</u> below above top of ground.			
(4) casing <u>PVC, 146</u> (material) (depth)			
<u>4</u> (size) if telescope see back.			
(5) screen <u>8</u> , <u>146</u> (length) (depth to top)			
<u>4</u> , <u>PVC</u> (size) (material)			
(6) pump <u>1/2</u> <u>10</u> (HP) (yield gpm)			
<u>Electric</u> (type power)			
(7) electric log <u>No</u> (yes or no)			
(organization running log)			
(8) how well bottom plugged <u>Sealed</u>			

DEPT. OF NATURAL RESOURCES
 BUREAU OF LAND & WATER RESOURCES


DEC - 9 1980

RECEIVED

DRILLERS REMARKS:

If well telescopes please sketch and show depths.

GROUND LEVEL

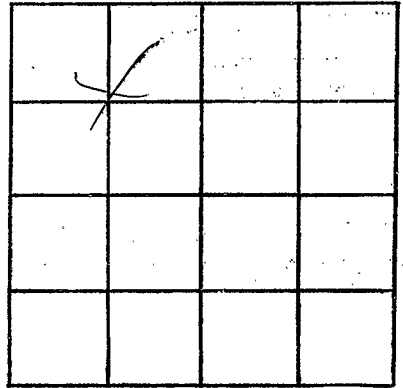

SECTION 22

Please indicate well location X:

ADDITIONAL INFORMATION

If more than one screen, show locations of each on sketch.