

Pike  
E 2029  
9-11-80

MISSISSIPPI  
BOARD OF WATER COMMISSIONERS.  
416 North State Street  
Jackson, Mississippi 39201

WATER WELL DRILLERS LOG

Sept-11 1980 Reynolds Inc Pike  
date well completed firm name county well located

LANDOWNER:  
Bill Welsh  
Rt 1 McComb  
(mailing address)

description of formations encountered	from	to
<u>Red clay</u>	<u>0</u>	<u>20</u>
<u>Red chert sand</u>	<u>20</u>	<u>90</u>
<u>Gravel &amp; sand</u>	<u>90</u>	<u>105</u>
<u>pebbly sand</u>	<u>105</u>	<u>168</u>
<u>Coarse sand &amp; pea gravel</u>	<u>168</u>	<u>190</u>

WELL LOCATION:  
sec. 24 T. 3 N R. 8 E  
6 miles east of McCombs  
(distance) (direction) (nearest town)

WELL PURPOSE: Domestic  
(home, irrigation, municipal, industrial)

WELL COMPLETION DATA:

(1) diameter (inches) 4"

(2) total depth (feet) 190

(3) static water level (feet) 110 below above top of ground.

(4) casing plastic bottom  
(material) (depth)

— if telescope see back.  
(size)

(5) screen 5' 185'  
(length) (depth to top)

4" plastic  
(size) (material)

(6) pump 1/2 10  
(HP) (yield gpm)

sheet  
(type power)

(7) electric log no  
(yes or no)

—  
(organization running log)

(8) how well bottom plugged wooden plug

DRILLERS REMARKS:


DEPT. OF NATURAL RESOURCES  
BUREAU OF LAND & WATER RESOURCES

MAY 14 1981

RECEIVED

If well telescopes please sketch and show depths.

GROUND LEVEL

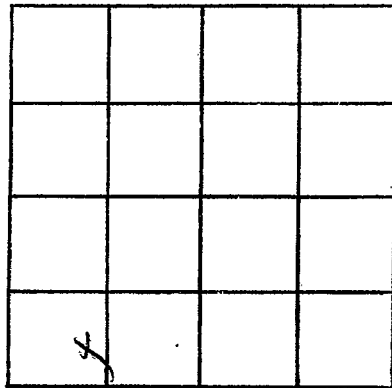

SECTION 24

Please indicate well location X.

ADDITIONAL INFORMATION

If more than one screen, show locations of each on sketch.