

MISSISSIPPI DEPARTMENT OF NATURAL RESOURCES

Bureau of Land and Water Resources

Southport Mall

P.O. Box 10631

Jackson, Mississippi 39209

WATER WELL DRILLERS LOG

Pike
E 2030
4/29/81

April 29 1981 Recess Well Co Pike
 date well completed firm name county well located


LANDOWNER:	description of formations encountered	from	to
<u>Fernwood Creste Court</u>	<u>sandy clay</u>	<u>0</u>	<u>12</u>
<u>Fernwood</u> (mailing address)	<u>sand</u>	<u>13</u>	<u>44</u>
WELL LOCATION:	<u>red gravel</u>	<u>44</u>	<u>57</u>
sec. <u>31</u> T- <u>3</u> N R- <u>8</u> E <u>in Fernwood</u> (distance) miles (direction) of (nearest town)			
WELL PURPOSE: <u>Drinking water</u> (home, irrigation, municipal, industrial)			
WELL COMPLETION DATA:			
(1) diameter (inches) <u>4"</u>			
(2) total depth (feet) <u>57</u>			
(3) static water level (feet) <u>12'</u> below above top of ground.			
(4) casing <u>plastic bottom</u> (material) (depth)			
_____ if telescope see back. (size)			
(5) screen <u>5'</u> <u>52'</u> (length) (depth to top)			
(6) pump <u>4"</u> <u>plastic</u> (size) (material)			
(7) pump <u>less others</u> (HP) (yield gpm)			
<u>split</u> (type power)			
(7) electric log <u>no</u> (yes or no)			
_____ (organization running log)			
(8) how well bottom plugged <u>bottom valves</u>			
DRILLERS REMARKS:			

DEPT. OF NATURAL RESOURCES
 BUREAU OF LAND & WATER RESOURCES

OCT 1 1981
 RECEIVED

If well telescopes please sketch and show depths.

GROUND LEVEL

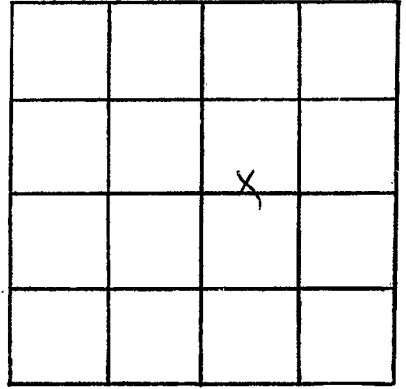

SECTION 31

Please indicate well location X.

ADDITIONAL INFORMATION

If more than one screen,
show locations of each on sketch.