

Pike
E 2032
3/28/81

MISSISSIPPI DEPARTMENT OF NATURAL RESOURCES
Bureau of Land and Water Resources
Southport Mall
P.O. Box 10631
Jackson, Mississippi 39209
WATER WELL DRILLERS LOG

March 28 1981 date well completed
Pikesville firm name
Pike county well located

LANDOWNER:
Fleet Allen
Rt 2 McComb (mailing address)


description of formations encountered	from	to
	Red Clay	0
Red sand	22	75
Gravel	75	83
pink chert	83	95
green sand	95	115

WELL LOCATION:
sec. 14 T 3 N R 8 E
4 1/2 miles east of McComb
(distance) (direction) (nearest town)

WELL PURPOSE: none
(home, irrigation, municipal, industrial)


- WELL COMPLETION DATA:
- (1) diameter (inches) 4"
 - (2) total depth (feet) 115'
 - (3) static water level (feet) 92' below top of ground.
 - (4) casing plastic bottom
(material) (depth)
 - 1" if telescope see back.
(size)
 - (5) screen 5' 110'
(length) (depth to top)
 - 4" plastic
(size) (material)
 - (6) pump 1/2 hp 10
(HP) (yield gpm)
 - electric
(type power)
 - (7) electric log no
(yes or no)
 - (organization running log)
 - (8) how well bottom plugged
back wash

DRILLERS REMARKS:

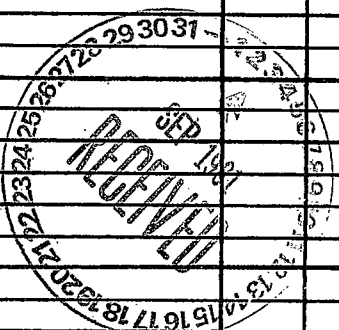

If well telescopes please sketch and show depths.

GROUND LEVEL

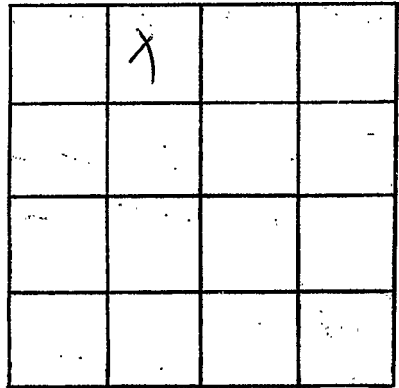

SECTION 14

Please indicate well location X.

ADDITIONAL INFORMATION

If more than one screen,
show locations of each on sketch.