

PIKE
E 2034
611181

MISSISSIPPI DEPARTMENT OF NATURAL RESOURCES
Bureau of Land and Water Resources
Southport Mall
P.O. Box 10631
Jackson, Mississippi 39209
WATER WELL DRILLERS LOG

June 11 1981 News Well for Pike
date well completed firm name county well located

LANDOWNER:
Billy M. & Kenzie
Fernwood
(mailing address)

description of formations encountered	from	to
sandy clay	0	16
sand & gravel	16	48
Red Chalk	48	60
sand & pebbles	60	77

WELL LOCATION:
sec. 32 T 3 N R 8 E
1 miles east of Fernwood
(distance) (direction) (nearest town)

WELL PURPOSE: home
(home, irrigation, municipal, industrial)

- WELL COMPLETION DATA:
- (1) diameter (inches) 4"
 - (2) total depth (feet) 72
 - (3) static water level (feet) 35 below top of ground.
 - (4) casing plastic Bottom
(material) (depth)
 - (5) screen 5' 67'
(length) (depth to top)
4" plastic
(size) (material)
 - (6) pump 1/2 HP 10
(HP) (yield gpm)
electric
(type power)
 - (7) electric log no
(yes or no)
(organization running log)
 - (8) how well bottom plugged
Back Wash

DRILLERS REMARKS:


DEPT. OF NATURAL RESOURCES
BUREAU OF LAND & WATER RESOURCES

JAN 4 - 1982

RECEIVED

If well telescopes please sketch and show depths.

GROUND LEVEL

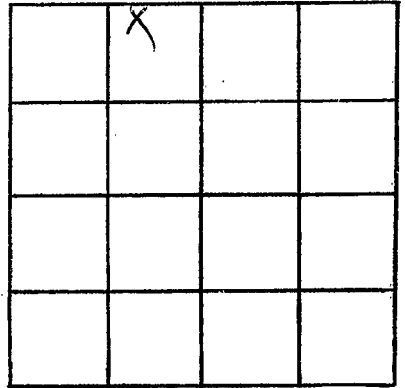

SECTION 32

Please indicate well location X.

ADDITIONAL INFORMATION

If more than one screen,
show locations of each on sketch.