

PIKE
E 2041

MISSISSIPPI DEPARTMENT OF NATURAL RESOURCES
Bureau of Land and Water Resources
Southport Mall
P.O. Box 10631
Jackson, Mississippi 39209
WATER WELL DRILLERS LOG

Nov. 9 1983 Reynolds Well Ser. Pike
date well completed firm name county well located

LANDOWNER:
Ronald Sharp
Rt 1 Mg, Comb
(mailing address)

| description of formations encountered | from | to |
|---------------------------------------|-----------|-----------|
| <u>Clay</u> | <u>0</u> | <u>8</u> |
| <u>White sand</u> | <u>8</u> | <u>60</u> |
| <u>gravel coarse sand</u> | <u>60</u> | <u>72</u> |

WELL LOCATION:
sec. 32 T. 3 N R. 8 E
1 1/2 miles west of Kennelwood
(distance) (direction) (nearest town)

WELL PURPOSE: house
(home, irrigation, municipal, industrial)

- WELL COMPLETION DATA:
- (1) diameter (inches) 4"
 - (2) total depth (feet) 72
 - (3) static water level (feet) 20 below top of ground.
 - (4) casing plastic (material) bottom (depth)
 - 1 (size) if telescope see back.
 - (5) screen 10' (length) 62' (depth to top)
 - 4" (size) plastic (material)
 - (6) pump 1/2 (HP) 20' (yield gpm)
 - split (type power)
 - (7) electric log no (yes or no)
 - (organization running log)

(8) how well bottom plugged back wash

DRILLERS REMARKS:
[Signature]


DEPT. OF NATURAL RESOURCES
BUREAU OF LAND & WATER RESOURCES

APR 30 1984

RECEIVED

If well telescopes please sketch and show depths.

GROUND LEVEL

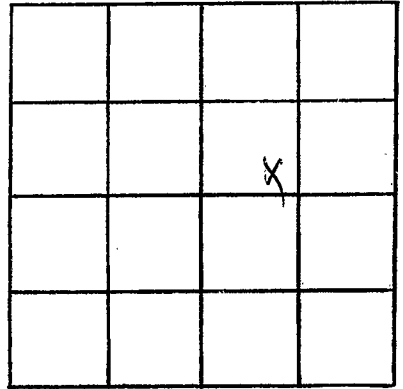

SECTION 32

Please indicate well location X.

ADDITIONAL INFORMATION

If more than one screen,
show locations of each on sketch.