

MISSISSIPPI DEPARTMENT OF NATURAL RESOURCES

Bureau of Land and Water Resources

Southport Mall

P.O. Box 10631

Jackson, Mississippi 39209

WATER WELL DRILLERS LOG

<i>Pike</i>
<i>E</i>
<i>2042</i>

*10-26*  
date well completed

19*83* *Felwood well Dr*  
firm name

*Pike*  
county well located

LANDOWNER:  
*Larry Carter*  
*Route 1, McComb, ms*  
(mailing address)

description of formations encountered	from	to
<i>Red clay</i>	<i>0</i>	<i>20</i>
<i>Red sand</i>	<i>20</i>	<i>90</i>
<i>Coarse sand &amp; gravel</i>	<i>90</i>	<i>140</i>

WELL LOCATION:  
sec. *1* T. *3* N. R. *8* E  
S W  
*5* miles *E* of *McComb*  
(distance) (direction) (nearest town)

WELL PURPOSE:  
(home, irrigation, municipal, industrial)  
*Home*

- WELL COMPLETION DATA:
- (1) diameter (inches) *4*
  - (2) total depth (feet) *140*
  - (3) static water level (feet) *105* below above top of ground.
  - (4) casing *4*, *132*  
(material) (depth)  
*4* if telescope see back.  
(size)
  - (5) screen *8*, *132*  
(length) (depth to top)  
*4*, *4*  
(size) (material)
  - (6) pump *1/2*, *10*  
(HP) (yield gpm)  
*EL*  
(type power)
  - (7) electric log *no*  
(yes or no)  
(organization running log)
  - (8) how well bottom plugged *Seal*

DEPT. OF NATURAL RESOURCES  
BUREAU OF LAND & WATER RESOURCES


DEC - 9 1983

RECEIVED

DRILLERS REMARKS:

If well telescopes please sketch and show depths.

GROUND LEVEL

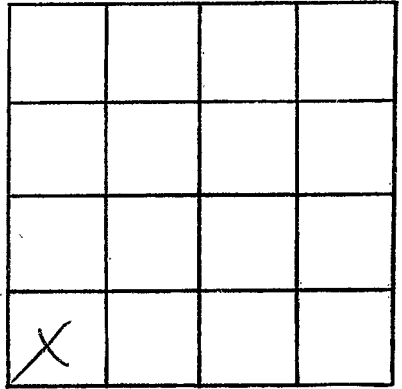

SECTION 1

Please indicate well location X.

ADDITIONAL INFORMATION

If more than one screen,  
show locations of each on sketch.