

MISSISSIPPI DEPARTMENT OF NATURAL RESOURCES

Bureau of Land and Water Resources

Southport Mall

P.O. Box 10631

Jackson, Mississippi 39209

WATER WELL DRILLERS LOG

PIKE
E
2043

10-8  
date well completed

1984 *F. J. Smallwell Sub-*  
firm name

*Pike*  
county well located

LANDOWNER:

*Jewell Boyal*  
*R.R. 3 m'comb*  
(mailing address)

description of formations encountered

from to

<i>Red Clay</i>	<i>0</i>	<i>20</i>
<i>Red Sand</i>	<i>20</i>	<i>80</i>
<i>white chills</i>	<i>80</i>	<i>190</i>
<i> coarse sand &amp; gravel</i>	<i>190</i>	<i>200</i>

WELL LOCATION:

sec. *14* T *3* N R *8* E  
S W  
*7* miles *E* of *m'comb*  
(distance) (direction) (nearest town)

WELL PURPOSE:

(home, irrigation, municipal, industrial) *Home*

WELL COMPLETION DATA:

- (1) diameter (inches) *4*
- (2) total depth (feet) *200*
- (3) static water level (feet) *95* below above top of ground.
- (4) casing *PVC*, *192*,  
(material) (depth)  
*4* if telescope see back.  
(size)
- (5) screen *8*, *192*  
(length) (depth to top)  
*4*, *PVC*  
(size) (material)
- (6) pump *1/2*, *10*  
(HP) (yield gpm)  
*Elm*  
(type power)
- (7) electric log *no*  
(yes or no)

(organization running log)

- (8) how well bottom plugged *Seal*

DEPT. OF NATURAL RESOURCES  
BUREAU OF LAND & WATER RESOURCES


DEC - 4 1984

RECEIVED

DRILLERS REMARKS:

If well telescopes please sketch and show depths.

GROUND LEVEL

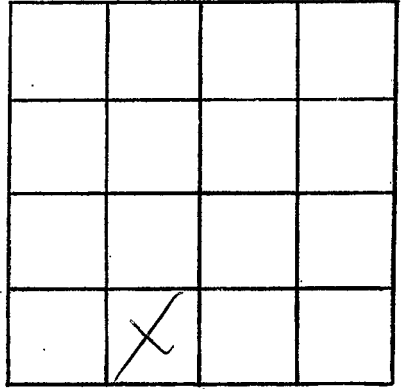

SECTION 14

Please indicate well location X.

ADDITIONAL INFORMATION

If more than one screen,  
show locations of each on sketch.