

~~PIKE~~
E 2044

MISSISSIPPI DEPARTMENT OF NATURAL RESOURCES
Bureau of Land and Water Resources
Southport Mall
P.O. Box 10631
Jackson, Mississippi 39209
WATER WELL DRILLERS LOG

2/24/84 19 Rayborn Drilling PIKE
date well completed firm name county well located

LANDOWNER:
RE Williams
Natchez, MS 39120
(mailing address)

description of formations encountered	from	to
Top Soil	0	15
Sand	116	160
Gumbo	161	240
Sand	241	305

WELL LOCATION:
sec. 8 T. 3 N. R. 8 E
8 miles SE of Summit
(distance) (direction) (nearest town)

WELL PURPOSE: oilfield
(home, irrigation, municipal, industrial)

WELL COMPLETION DATA:

(1) diameter (inches) 3"

(2) total depth (feet) 305'

(3) static water level (feet) 100' below top of ground

(4) casing b/k pipe (material), 285' (depth)
3" (size) if telescope see back.

(5) screen 20' (length), 285' (depth to top)
3" (size), slotted pipe (material)

(6) pump 50 (HP), 50 (yield gpm)
(type power)

(7) electric log no (yes or no)
(organization running log)

(8) how well bottom plugged wood

DEPT. OF NATURAL RESOURCES
BUREAU OF LAND & WATER RESOURCES


APR 12 1984

RECEIVED

DRILLERS REMARKS:

If well telescopes please sketch and show depths.

GROUND LEVEL

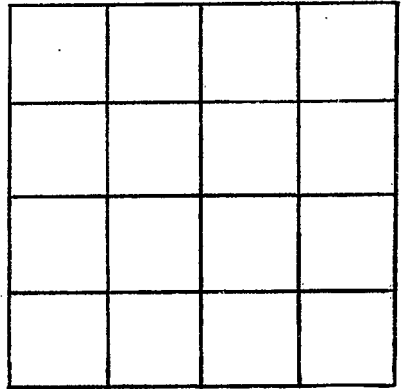

SECTION _____

Please indicate well location X.

ADDITIONAL INFORMATION

If more than one screen,
show locations of each on sketch.