

MISSISSIPPI DEPARTMENT OF NATURAL RESOURCES

Bureau of Land and Water Resources

Southport Mall

P.O. Box 10631

Jackson, Mississippi 39209

WATER WELL DRILLERS LOG

PIKE
E 2046

May 22 1984  
date well completed

Runwell Inc  
firm name

Pike  
county well located

LANDOWNER:	description of formations encountered	from	to
Ed Thompson	Clay	0	15
Pt. 1 McComb (mailing address)	Red sand	15	60
	sand & gravel	60	111
<b>WELL LOCATION:</b>			
sec 19 T 3 N R 8 E			
1/2 miles E.S.E. of McComb (distance) (direction) (nearest town)			
<b>WELL PURPOSE:</b> <u>Trailer</u> (home, irrigation, municipal, industrial)			
<b>WELL COMPLETION DATA:</b>			
(1) diameter (inches) <u>4"</u>			
(2) total depth (feet) <u>111</u>			
(3) static water level (feet) <u>70</u> below above top of ground.			
(4) casing <u>plastic</u> <u>bottom</u> (material) (depth)			
<u> </u> if telescope see back. (size)			
(5) screen <u>6'</u> <u>105'</u> (length) (depth to top)			
<u>4"</u> <u>plastic</u> (size) (material)			
(6) pump <u>1/2</u> <u>10</u> (HP) (yield gpm)			
<u>electric</u> (type power)			
(7) electric log <u>no</u> (yes or no)			
<u> </u> (organization running log)			
(8) how well bottom plugged <u>back wash</u>			
<b>DRILLERS REMARKS:</b>			


DEPT. OF NATURAL RESOURCES  
BUREAU OF LAND & WATER RESOURCES

JUL 30 1984

RECEIVED

If well telescopes please sketch and show depths.

GROUND LEVEL

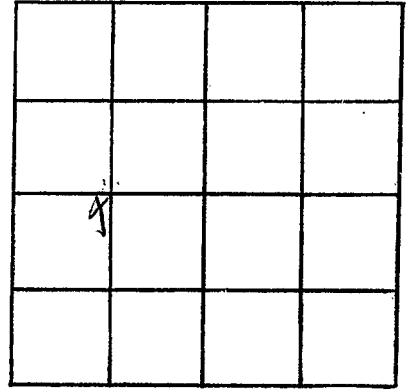

SECTION 19

Please indicate well location X.

ADDITIONAL INFORMATION

If more than one screen,  
show locations of each on sketch.