

MISSISSIPPI DEPARTMENT OF NATURAL RESOURCES

Bureau of Land and Water Resources

Southport Mall

P.O. Box 10631

Jackson, Mississippi 39209

WATER WELL DRILLERS LOG

Pike
E
2047

1-8
date well completed

1985 *F. J. G. Well Service* *Pike*
firm name

county well located

LANDOWNER:
Karen Hodges
P.O. 2, McComb, ms.
(mailing address)

description of formations encountered	from	to
<i>Red clay</i>	<i>0</i>	<i>20</i>
<i>Red gravel</i>	<i>20</i>	<i>80</i>
<i>White chalk</i>	<i>80</i>	<i>160</i>
<i>Fine sand</i>	<i>160</i>	<i>185</i>
<i>Coarse sand & gravel</i>	<i>185</i>	<i>200</i>

WELL LOCATION:
sec. 14 T 3 N R 8 E
S W
6 miles E of McComb
(distance) (direction) (nearest town)

WELL PURPOSE: Home
(home, irrigation, municipal, industrial)

- WELL COMPLETION DATA:
- (1) diameter (inches) 4
 - (2) total depth (feet) 200
 - (3) static water level (feet) 85 below above top of ground.
 - (4) casing PVC, 190,
(material) (depth)
4 if telescope see back.
(size)
 - (5) screen 10, 190
(length) (depth to top)
4, PVC
(size) (material)
 - (6) pump 1/2, 10
(HP) (yield gpm)
elec
(type power)
 - (7) electric log no
(yes or no)
no
(organization running log)
 - (8) how well bottom plugged sand fill

RECEIVED
MAR 5 - 1985


Department of Natural Resources
Bureau of Land & Water Resources

DRILLERS REMARKS:

If well telescopes please sketch and show depths.

GROUND LEVEL

If more than one screen, show locations of each on sketch.

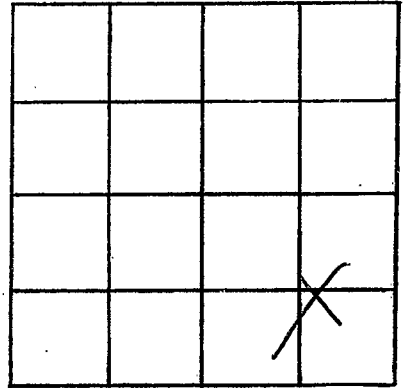

SECTION 14

Please indicate well location X.

ADDITIONAL INFORMATION