

MISSISSIPPI DEPARTMENT OF NATURAL RESOURCES

Bureau of Land and Water Resources

Southport Mall

P.O. Box 10631

Jackson, Mississippi 39209

WATER WELL DRILLERS LOG

PIKE
E 2048

2-8 1985
date well completed

Flanagan Well Dr
firm name

Pike
county well located

LANDOWNER:	description of formations encountered	from	to
<u>Henry Sharp</u>			
<u>R.R. 1 McComb, Ms.</u> (mailing address)	<u>Red clay</u>	<u>0</u>	<u>20</u>
	<u>Red Sand</u>	<u>20</u>	<u>135</u>
WELL LOCATION: sec. <u>1</u> T. <u>3</u> N. R. <u>8</u> E S W <u>6</u> miles <u>E</u> of <u>McComb</u> (distance) (direction) (nearest town)	<u>Coarse Sand & gravel</u>	<u>135</u>	<u>150</u>
WELL PURPOSE: (home, irrigation, municipal, industrial)			
WELL COMPLETION DATA:			
(1) diameter (inches) <u>4</u>			
(2) total depth (feet) <u>150</u>			
(3) static water level (feet) <u>115</u> below top of ground.			
(4) casing <u>PVC</u> , <u>142</u> , (material) (depth) <u>4</u> if telescope see back. (size)			
(5) screen <u>8</u> , <u>142</u> (length) (depth to top) <u>4</u> , <u>PVC</u> (size) (material)			
(6) pump <u>1/2</u> , <u>10</u> (HP) (yield gpm) <u>elec</u> (type power)			
(7) electric log <u>no</u> (yes or no) (organization running log)			
(8) how well bottom plugged <u>Sand sh</u>			

RECEIVED


MAR 5 - 1985

DRILLERS REMARKS:

Department of Natural Resources
Bureau of Land & Water Resources

If well telescopes please
sketch and show depths.

GROUND LEVEL

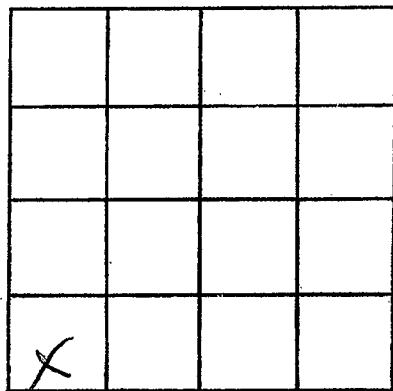

SECTION /

Please indicate well location X.

ADDITIONAL INFORMATION

If more than one screen,
show locations of each on sketch.