

MISSISSIPPI DEPARTMENT OF NATURAL RESOURCES

Bureau of Land and Water Resources

Southport Mall

P.O. Box 10631

Jackson, Mississippi 39209

WATER WELL DRILLERS LOG

PIKE
E 209

2-26 1985
date well completed

Fitzgerald Well Inc
firm name

Pike
county well located

LANDOWNER:
Pidgeon Ridge Range
R.R. McComb, Jr.
(mailing address)

description of formations encountered	from	to
<u>Red clay</u>	<u>0</u>	<u>20</u>
<u>Red sand</u>	<u>20</u>	<u>50</u>
<u>Orange sandstone</u>	<u>50</u>	<u>76</u>

WELL LOCATION:
sec. 25 T 3 N R 8 E
S W
1 miles S of McComb
(distance) (direction) (nearest town)

WELL PURPOSE: Home
(home, irrigation, municipal, industrial)

- WELL COMPLETION DATA:
- (1) diameter (inches) 4
 - (2) total depth (feet) 76
 - (3) static water level (feet) 45 below above top of ground.
 - (4) casing pvc 66,
(material), (depth)
4 if telescope see back.
(size)
 - (5) screen 10, 66
(length) (depth to top)
4, pvc
(size) (material)
 - (6) pump 1/2, 10
(HP) (yield gpm)
elec
(type power)
 - (7) electric log no
(yes or no)
(organization running log)
 - (8) how well bottom plugged Sealed


DRILLERS REMARKS:

RECEIVED
MAR 5 - 1985

Department of Natural Resources
Bureau of Land & Water Resources

If well telescopes please
sketch and show depths.

GROUND LEVEL

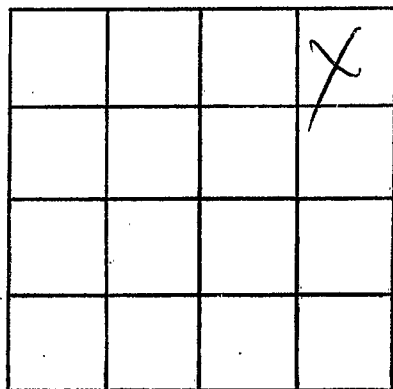

SECTION 25

Please indicate well location X.

ADDITIONAL INFORMATION

If more than one screen,
show locations of each on sketch.