

PIKE
E 2081
35-85

MISSISSIPPI
BOARD OF WATER COMMISSIONERS
416 North State Street
Jackson, Mississippi 39201

WATER WELL DRILLERS LOG

3/5/85 19 Staffer Well Ser Pike
date well completed firm name county well located

LANDOWNER: <u>Thomas Bourman</u>	description of formations encountered	from	to
	top soil	0	1'
(mailing address)	Red clay	1'	41'
WELL LOCATION: sec. <u>9</u> T- <u>3</u> (N) R- <u>7</u> (E)	gravel	41'	81'
<u>5</u> miles <u>East</u> of <u>Mogridge</u> (distance) (direction) (nearest town)	dry sand	81'	122'
WELL PURPOSE: <u>Home</u> (home, irrigation, municipal, industrial)	sand & gravel	122'	157'
WELL COMPLETION DATA:			
(1) diameter (inches) <u>4"</u>			
(2) total depth (feet) <u>157'</u>			
(3) static water level (feet) <u>35</u> below above top of ground.			
(4) casing <u>Plastic</u> (material) (depth)			
<u>4"</u> (size) if telescope see back.			
(5) screen <u>10'</u> (length) (depth to top)			
<u>4"</u> <u>Plastic</u> (size) (material)			
(6) pump <u>1/2</u> <u>11</u> (HP) (yield gpm)			
<u>electric</u> (type power)			
(7) electric log (yes or no)			
(organization running log)			
(8) how well bottom plugged <u>BWV</u>			


RECEIVED
MAR 28 1985

Department of Natural Resources
Bureau of Land & Water Resources

DRILLERS REMARKS:
Wade Brown Assisted
by Esley Stafford

If well telescopes please sketch and show depths.

GROUND LEVEL

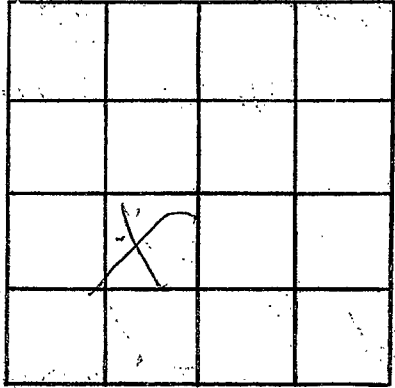

SECTION 9

Please indicate well location X.

ADDITIONAL INFORMATION

If more than one screen, show locations of each on sketch.