

MISSISSIPPI DEPARTMENT OF NATURAL RESOURCES

Bureau of Land and Water Resources

Southport Mall

P.O. Box 10631

Jackson, Mississippi 39209

WATER WELL DRILLERS LOG

L

Pike  
E 205  
7-10-85

7-10 1985 Fitzgerald Well Serv Pike  
date well completed firm name county well located

LANDOWNER:	description of formations encountered	from	to
<u>Byron Wilkerson</u>			
<u>RR-1, McComb, Ms.</u> (mailing address)	<u>Red Clay</u> <u>Red Sand</u> <u>Coarse Sand &amp; gravel</u>	<u>0</u> <u>20</u> <u>120</u>	<u>20</u> <u>120</u> <u>134</u>
WELL LOCATION: sec <u>2</u> T <u>3</u> (N) R <u>8</u> (E) <u>5</u> miles <u>E</u> of <u>McComb</u> (distance) (direction) (nearest town)			
WELL PURPOSE: <u>Home</u> (home, irrigation, municipal, industrial)			
WELL COMPLETION DATA:			
(1) diameter (inches) <u>4</u>			
(2) total depth (feet) <u>134</u>			
(3) static water level (feet) <u>84</u> below above top of ground.			
(4) casing <u>PVC</u> , <u>124</u> (material) (depth) <u>4</u> if telescope see back. (size)			
(5) screen <u>10</u> , <u>124</u> (length) (depth to top) <u>4</u> , <u>PVC</u> (size) (material)			
(6) pump <u>1/2</u> , <u>10</u> (HP) (yield gpm) <u>Ele</u> (type power)			
(7) electric log <u>No</u> (yes or no) <u>Ele</u> (organization running log)			
(8) how well bottom plugged <u>Seal off</u>			
DRILLERS REMARKS:			


RECEIVED

JUL 25 1985

Department of Natural Resources  
Bureau of Land & Water Resources

If well telescopes please sketch and show depths.

GROUND LEVEL

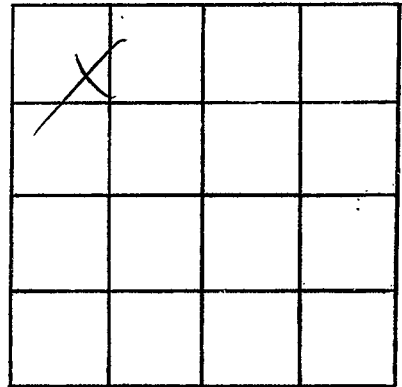

SECTION 2

Please indicate well location X.

ADDITIONAL INFORMATION

If more than one screen,  
show locations of each on sketch.