

MISSISSIPPI DEPARTMENT OF NATURAL RESOURCES

Bureau of Land and Water Resources

Southport Mall

P.O. Box 10631

Jackson, Mississippi 39209

WATER WELL DRILLERS LOG

E 2053
PIKE
8-17-85

8-17-~~88~~ 1985  
date well completed

*Fitzgerald Well Serv*  
firm name

*Pike*  
county well located


LANDOWNER:	description of formations encountered	from	to
<i>Gene Deen</i>			
<i>R.R. McComb, Jr.</i> (mailing address)	<i>Red clay</i>	<i>0</i>	<i>20</i>
	<i>Red sand</i>	<i>20</i>	<i>90</i>
	<i>Coarse sand &amp; gravel</i>	<i>90</i>	<i>129</i>
WELL LOCATION:			
sec. <i>9</i> T <i>3</i> N R <i>8</i> E S W			
<i>3</i> miles <i>E</i> of <i>McComb</i> (distance) (direction) (nearest town)			
WELL PURPOSE: (home, irrigation, municipal, industrial)			
WELL COMPLETION DATA:			
(1) diameter (inches) <i>4</i>			
(2) total depth (feet) <i>129</i>			
(3) static water level (feet) <i>90</i> below above top of ground.			
(4) casing <i>4" PVC</i> , <i>119</i> , (material) (depth)			
<i>4</i> if telescope see back. (size)			
(5) screen <i>10</i> , <i>119</i> (length) (depth to top)			
<i>4</i> , <i>PVC</i> (size) (material)			
(6) pump <i>3/4</i> , <i>15</i> (HP) (yield gpm)			
<i>Elmer</i> (type power)			
(7) electric log <i>no</i> (yes or no)			
<i>Elmer</i> (organization running log)			
(8) how well bottom plugged <i>Seal thick</i>			
DRILLERS REMARKS:			

**RECEIVED**  
SEP 13 1985

Department of Natural Resources  
Bureau of Land & Water Resources

If well telescopes please sketch and show depths.

GROUND LEVEL

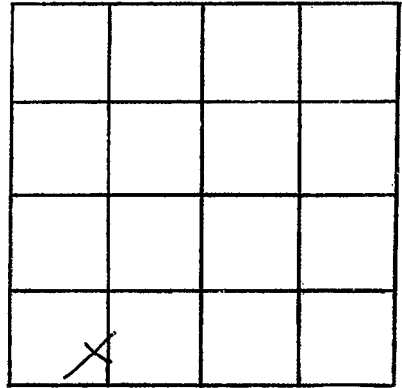

SECTION 9

Please indicate well location X.

ADDITIONAL INFORMATION

If more than one screen,  
show locations of each on sketch.