

MISSISSIPPI DEPARTMENT OF NATURAL RESOURCES

Bureau of Land and Water Resources

Southport Mall

P.O. Box 10631

Jackson, Mississippi 39209

WATER WELL DRILLERS LOG

PIKE
E 2055

Sept 27 1985 Rever Well Dr Pike  
 date well completed firm name county well located


LANDOWNER:	description of formations encountered	from	to
<u>Reggie Martin</u> <u>Rt 2 McComb</u> (mailing address)			
WELL LOCATION:			
sec. <u>10</u> T <u>3</u> N R <u>8</u> E			
<u>4</u> miles <u>east</u> of <u>McComb</u>			
(distance) (direction) (nearest town)			
WELL PURPOSE: <u>house</u>			
(home, irrigation, municipal, industrial)			
WELL COMPLETION DATA:			
(1) diameter (inches) <u>4"</u>			
(2) total depth (feet) <u>100</u>			
(3) static water level (feet) <u>12</u> below top of ground.			
(4) casing <u>plastic</u> <u>batton</u>			
(material) (depth)			
(size) if telescope see back.			
(5) screen <u>5'</u> <u>95'</u>			
(length) (depth to top)			
(size) <u>4"</u> <u>plastic</u>			
(material)			
(6) pump <u>hyathus</u>			
(HP) (yield gpm)			
(type power)			
(7) electric log <u>no</u>			
(yes or no)			
(organization running log)			
(8) how well bottom plugged <u>back wash</u>			
DRILLERS REMARKS:			

RECEIVED  
 JUN 27 1985

Department of Natural Resources  
 Bureau of Land and Water Resources

If well telescopes please sketch and show depths.

GROUND LEVEL

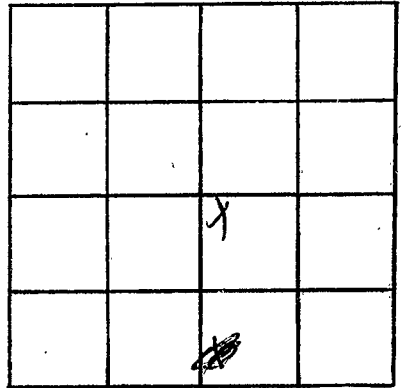

SECTION 10

Please indicate well location X.

ADDITIONAL INFORMATION

If more than one screen,  
show locations of each on sketch.