

MISSISSIPPI DEPARTMENT OF NATURAL RESOURCES

Bureau of Land and Water Resources

Southport Mall

P.O. Box 10631

Jackson, Mississippi 39209

WATER WELL DRILLERS LOG

PIKE
E 20530

Oct 10

19

85 Rivers weller

Pike

date well completed

firm name

county well located

LANDOWNER:
P. A. Deer P. III
Rt 2 McClomb
(mailing address)

description of formations encountered	from	to
Red sand clay	0	27
Red sand	27	90
Gravel (big)	90	128
Coarse sand	128	155
Coated sand + small gravel	155	175

WELL LOCATION:
sec. 14 T. 3 N R. 8 E
1/2 miles east of McClomb
(distance) (direction) (nearest town)

WELL PURPOSE: house
(home, irrigation, municipal, industrial)

WELL COMPLETION DATA:

- (1) diameter (inches) 4"
- (2) total depth (feet) 175
- (3) static water level (feet) 91 below top of ground
- (4) casing plastic bottom
(material) (depth)
- (size) if telescope see back.
- (5) screen 5' (length) 170 (depth to top)
- (size) (material) 4" plastic
- (6) pump 3/4 hp (HP) 10 (yield gpm)
- (type power) sheet
- (7) electric log no (yes or no)
- (organization running log)
- (8) how well bottom plugged back wash

DRILLERS REMARKS:
[Signature]


REGISTERED
LAND SURVEYOR

JUL 01 1985

Department of Natural Resources
Bureau of Land & Water Resources

If well telescopes please sketch and show depths.

GROUND LEVEL

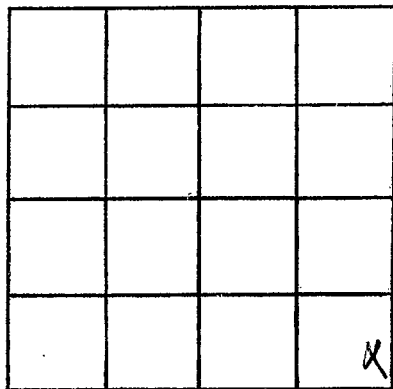

SECTION 14

Please indicate well location X.

ADDITIONAL INFORMATION

If more than one screen,
show locations of each on sketch.