

MISSISSIPPI DEPARTMENT OF NATURAL RESOURCES

Bureau of Land and Water Resources

Southport Mall

P.O. Box 10631

Jackson, Mississippi 39209

WATER WELL DRILLERS LOG

E 2087
PIKE
9-4-85

9-4 1985 Fitzgerald Well Serv Pike  
 date well completed firm name county well located

LANDOWNER:

Gene Robinson  
R.R. 2, McComb, ms.  
 (mailing address)

description of formations encountered

from

to

Red clay	0	20
Red granite	20	95
White chalk	95	160
Fine sand	160	185
Coarse sand & gravel	185	198

WELL LOCATION:

sec. 14 T. 3 N R. 8 E  
 S W  
6 miles E of McComb  
 (distance) (direction) (nearest town)


WELL PURPOSE:

Home  
(home, irrigation, municipal, industrial)

WELL COMPLETION DATA:

- (1) diameter (inches) 4
- (2) total depth (feet) 198
- (3) static water level (feet) 110 below above top of ground.
- (4) casing pvc, 188,  
 (material) (depth)  
4 if telescope see back.  
 (size)
- (5) screen 10, 188  
 (length) (depth to top)  
4, pvc  
 (size) (material)
- (6) pump 1/2, 10  
 (HP) (yield gpm)  
elec  
 (type power)
- (7) electric log No  
 (yes or no)  
 (organization running log)
- (8) how well bottom plugged See log


DRILLERS REMARKS:

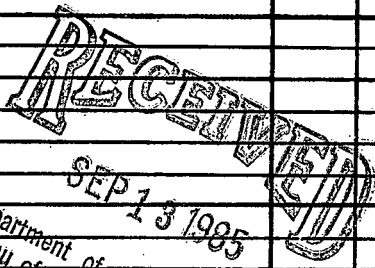

Department of Natural Resources  
 Bureau of Land & Water Resources

If well telescopes please sketch and show depths.

GROUND LEVEL

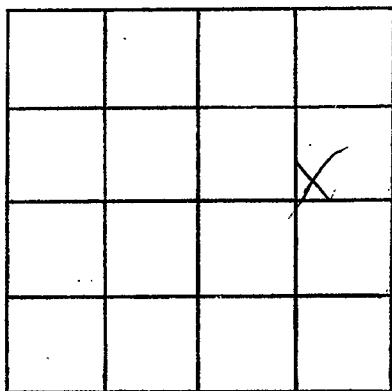

SECTION 14

Please indicate well location X.

ADDITIONAL INFORMATION

If more than one screen,  
show locations of each on sketch.