

MISSISSIPPI DEPARTMENT OF NATURAL RESOURCES

Bureau of Land and Water Resources

Southport Mall

P.O. Box 10631

Jackson, Mississippi 39209

WATER WELL DRILLERS LOG

PIKE  
E 2058

12-11-

1985

Fitzgerald well driller

firm name

Pike

county well located

LANDOWNER:

Lee Felder

description of formations encountered

from

to

RR-2, McComb, ms.  
(mailing address)

red gravel	0	45
red sand	45	90
coarse sand	90	112

WELL LOCATION:

sec. 19 T-3 N R-8 E  
S W  
1 miles S of McComb  
(distance) (direction) (nearest town)

WELL PURPOSE:

Home  
(home, irrigation, municipal, industrial)

WELL COMPLETION DATA:

- (1) diameter (inches) 4
- (2) total depth (feet) 112
- (3) static water level (feet) 72 below top of ground.
- (4) casing PVC, 102 (material) (depth)  
4 (size) if telescope see back.
- (5) screen 10 (length) 102 (depth to top)  
4 (size) PVC (material)
- (6) pump 1/2 (HP) 10 (yield gpm)  
electric (type power)
- (7) electric log 700 (yes or no)  
(organization running log)
- (8) how well bottom plugged Sand plug

RECEIVED


DEC 30 1985

Department of Natural Resources  
Bureau of Land & Water Resources

DRILLERS REMARKS:

If well telescopes please sketch and show depths.

GROUND LEVEL

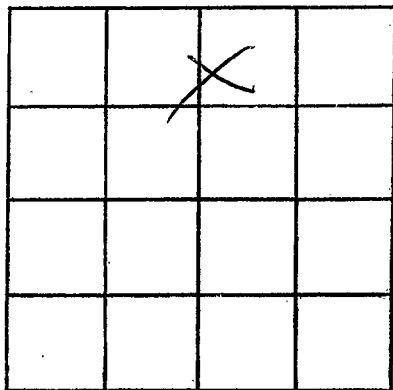

SECTION 19

Please indicate well location X.

ADDITIONAL INFORMATION

If more than one screen,  
show locations of each on sketch.